

Louder
 F 2002
 2/25/76

MISSISSIPPI
 BOARD OF WATER COMMISSIONERS
 416 North State Street
 Jackson, Mississippi 39201

WATER WELL DRILLERS LOG

Feb 25 1976 *Norman E. Edwards* *Louder County*
 date well completed firm name county well located

LANDOWNER: *Lonnie Baxton*
Columbus, Miss
 (mailing address)

description of formations encountered	from	to
<i>Red Clay top Soil</i>	0	18
<i>Clay</i>	18	220
<i>Sand</i>	220	350
<i>Sand</i>	350	450

WELL LOCATION:
 sec. 19 T. 19 N. R. 17 E.
6 miles West of Columbus
 (distance) (direction) (nearest town)

WELL PURPOSE: Home
 (home, irrigation, municipal, industrial)

- WELL COMPLETION DATA:
- (1) diameter (inches) 5"
 - (2) total depth (feet) 450
 - (3) static water level (feet) 100 below/above top of ground.
 - (4) casing 23' 5" casing (material) (depth)
 - (size) If telescope see back.
 - (5) screen none (length) (depth to top)
 - (size) (material)
 - (6) pump 1/2 10 (HP) (yield gpm)
 - (type power)
 - (7) electric log (yes or no)
 - (organization running log)
 - (8) how well bottom plugged OK


RECEIVED
 JUN 8 1976

DRILLERS REMARKS:

MISSISSIPPI BOARD OF WATER COMMISSIONERS

If well telescopes please
sketch and show depths.

GROUND LEVEL

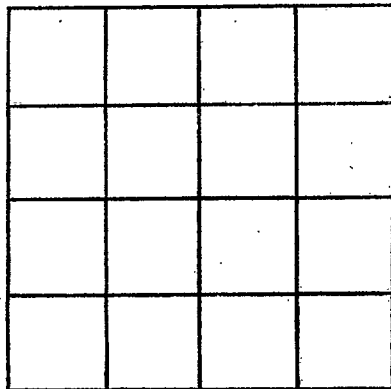

SECTION _____

Please indicate well location X.

ADDITIONAL INFORMATION

If more than one screen,
show locations of each on sketch.