

LOWNDES

F 2006

6-24-76

MISSISSIPPI BOARD OF WATER COMMISSIONERS  
416 North State Street  
13E Jackson, Mississippi 39201

WATER WELL DRILLERS LOG

6-24 1976  
date well completed

W. J. REEVES & SON  
firm name

LOWNDES  
county well located

LANDOWNER: USA  
COLUMBUS LOCK & DAM  
COLUMBUS  
(mailing address)

description of formations encountered	from	to
FILL	0	12
CLAY	12	50
SAND & GRAVEL	30	41
BLUE CLAY	41	122
" SAND	122	136
" CLAY	136	160
" SAND	160	192
" CLAY	192	200

WELL LOCATION:  
sec. 2 T. 18 N. R. 12  
3 miles W of COLUMBUS  
(distance) (direction) (nearest town)

WELL PURPOSE: IND  
(home, irrigation, municipal, industrial)

WELL COMPLETION DATA:

(1) diameter (inches) 4

(2) total depth (feet) 200

(3) static water level (feet) 45 below above top of ground.

(4) casing STEEL, 4 1/2 (material) (depth)

4 If telescope see back. (size)

(5) screen (length) (depth to top)

(size) (material)

(6) pump 1/2 (HP) 7 (yield gpm)

ELECT (type power)

(7) electric log NO (yes or no)

(organization running log)

(8) how well bottom plugged OPEN


DRILLERS REMARKS:

RECEIVED  
APR 12 1977

MISS. Bd. OF WATER COMMISSIONERS

If well telescopes please sketch and show depths.

GROUND LEVEL

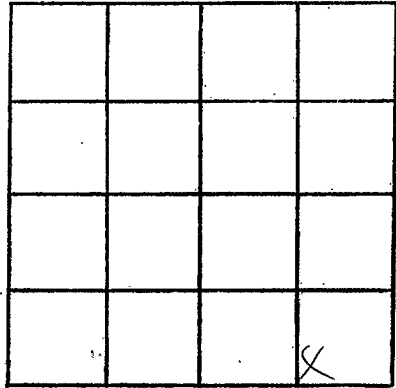

SECTION 3

Please indicate well location X.

ADDITIONAL INFORMATION

If more than one screen,  
show locations of each on sketch.