

Lowndes  
F 2007  
8/76

MISSISSIPPI  
BOARD OF WATER COMMISSIONERS  
416 North State Street  
Jackson, Mississippi 39201

WATER WELL DRILLERS LOG

Lowndes

Aug 1976 date well completed  
Norman E. Eber firm name  
Lowndes county well located

LANDOWNER	description of formations encountered	from	to
Jim Hamilton	Red Clay	0	18
Columbus, Miss (mailing address)	Chalk	18	230
	Sand	230	350

WELL LOCATION:  
sec. 18 T. 19 N. R. 17 E  
S W  
7 miles West of Columbus  
(distance) (direction) (nearest town)

WELL PURPOSE:  
(home, irrigation, municipal, industrial)

- WELL COMPLETION DATA:
- (1) diameter (inches) 4 1/2
  - (2) total depth (feet) 350
  - (3) static water level (feet) 130 below top of ground.
  - (4) casing 21' 5" Steel (material) (depth)
  - (size) If telescope see back.
  - (5) screen (length) (depth to top)
  - (size) (material)
  - (6) pump 3/4 (HP) 12 (yield gpm)
  - Elect (type power)
  - (7) electric log 920 (yes or no)
  - (organization running log)
  - (8) how well bottom plugged 0


DRILLERS REMARKS:

RECEIVED

SEP - 7 1976

If well telescopes please sketch and show depths.

GROUND LEVEL

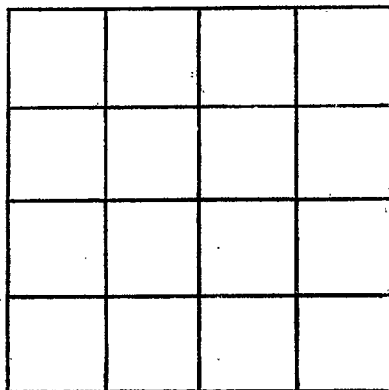

SECTION \_\_\_\_\_

Please indicate well location X.

ADDITIONAL INFORMATION

If more than one screen, show locations of each on sketch.