

Lowndes  
F 2008  
8-24-76

MISSISSIPPI  
 BOARD OF WATER COMMISSIONERS  
 416 North State Street  
 Jackson, Mississippi 39201

13L

WATER WELL DRILLERS LOG

8-24 1976  
 date well completed

WJ REEVES & SON  
 firm name

LOWNDES  
 county well located

LANDOWNER: USA  
COLUMBUS LOCK & DAM  
COLUMBUS  
 (mailing address)

description of formations encountered

from

to

<u>FILL</u>	<u>0</u>	<u>18</u>
<u>SAND &amp; GRAVEL</u>	<u>38</u>	<u>42</u>
<u>BLUE CLAY</u>	<u>42</u>	<u>94</u>
<u>" SAND</u>	<u>94</u>	<u>106</u>
<u>" CLAY</u>	<u>106</u>	<u>144</u>
<u>" SAND</u>	<u>144</u>	<u>175</u>

WELL LOCATION:

sec. 12 T. 10 N. R. 11 E.  
3 miles W of COLUMBUS  
 (distance) (direction) (nearest town)

WELL PURPOSE: IND  
 (home, irrigation, municipal, industrial)

WELL COMPLETION DATA:

- (1) diameter (inches) 4
- (2) total depth (feet) 175
- (3) static water level (feet) 114 below above top of ground.
- (4) casing PVC 155  
 (material) (depth)  
4 if telescope see back.  
 (size)
- (5) screen 20 155  
 (length) (depth to top).  
4 PVC  
 (size) (material)
- (6) pump 1/2 7  
 (HP) (yield gpm)  
ELECT  
 (type power)
- (7) electric log No  
 (yes or no)

(organization running log)

(8) how well bottom plugged SAND


DRILLERS REMARKS:

**RECEIVED**  
 APR 12 1977

MISS. BD. OF WATER COMMISSIONERS

If well telescopes please sketch and show depths.

GROUND LEVEL

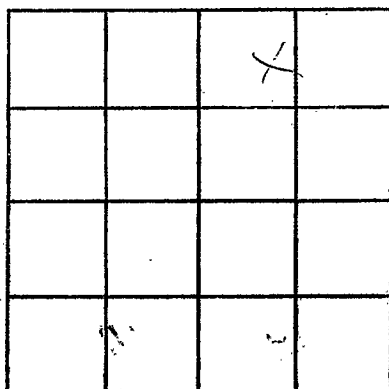

SECTION 11

Please indicate well location X.

ADDITIONAL INFORMATION

If more than one screen,  
show locations of each on sketch.