

LOWNDES
F 2009
10-13-76

MISSISSIPPI
 BOARD OF WATER COMMISSIONERS
 416 North State Street
 Jackson, Mississippi 39201

WATER WELL DRILLERS LOG

10-13 1976 W. J. REEVES & SON LOWNDES
 date well completed firm name county well located

LANDOWNER: PENN. TAYLOR
RT. 3
COLUMBUS
 (mailing address)
 WELL LOCATION:
 sec. 28 T. 19 N R. 17 E
5 miles W of COLUMBUS
 (distance) (direction) (nearest town)

description of formations encountered	from	to
<u>CLAY</u>	<u>0</u>	<u>18</u>
<u>BLUE CLAY</u>	<u>18</u>	<u>25</u>
<u>" SAND</u>	<u>215</u>	<u>227</u>
<u>" CLAY</u>	<u>227</u>	<u>285</u>
<u>BLUE SAND + CLAY STARS</u>	<u>285</u>	<u>360</u>

WELL PURPOSE: HOME
 (home, irrigation, municipal, industrial)

WELL COMPLETION DATA:
 (1) diameter (inches) 4
 (2) total depth (feet) 360
 (3) static water level (feet) 93 below above top of ground.
 (4) casing STEEL, 24
 (material) (depth)
4 If telescope see back.
 (size)
 (5) screen _____
 (length) (depth to top)
 (size) (material)
 (6) pump 1/2 _____
 (HP) (yield gpm)
ELECT
 (type-power)
 (7) electric log NO
 (yes or no)
 (organization running log)
 (8) how well bottom plugged OPEN


RECEIVED
 APR 12 1977

DRILLERS REMARKS:

MISS. RD. OF WATER COMMISSIONERS

If well telescopes please
sketch and show depths.

GROUND LEVEL

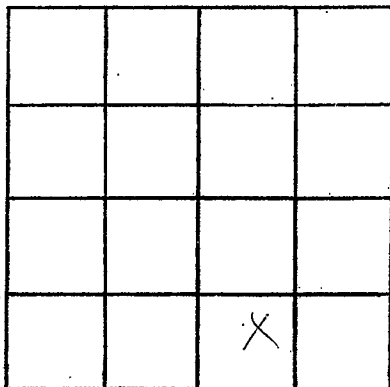

SECTION 28

Please indicate well location X.

ADDITIONAL INFORMATION

If more than one screen,
show locations of each on sketch.