

LOWNDES
F 2012
7-16-77

MISSISSIPPI
 BOARD OF WATER COMMISSIONERS
 416 North State Street
 Jackson, Mississippi 39201

WATER WELL DRILLERS LOG

July 16 1977 date well completed
 Mid-South Drilling firm name
 Lowndes county well located


LANDOWNER:	description of formations encountered	from	to
Glen Shuman	Yellow Clay	0	14
Columbus MS	Blue shale	14	43
(mailing address)	Rock	43	45
WELL LOCATION:	Blue shale	45	210
sec. 17 T. 19 N. R. 17 E.	Sand	210	234
8 miles West of Columbus	Blue shale & Sand	234	396
(distance) (direction) (nearest town)	Rock strata & Sand	396	435
WELL PURPOSE: Farm	Blue shale	435	450
(home, irrigation, municipal, industrial)			
WELL COMPLETION DATA:			
(1) diameter (inches) 4 1/2 in.			
(2) total depth (feet) 450 ft.			
(3) static water level (feet) 80 below top of ground.			
(4) casing PVC, 200 (material) (depth)			
(size) if telescope see back.			
(5) screen NONE (length) (depth to top)			
(size) (material)			
(6) pump 3/4 (HP) 10 (yield gpm)			
(type power)			
(7) electric log NONE (yes or no)			
(organization running log)			
(8) how well bottom plugged NONE			
DRILLERS REMARKS:			

SEP 14 1977

MISS. BD. OF WATER COMMISSIONERS

If well telescopes please sketch and show depths.

GROUND LEVEL

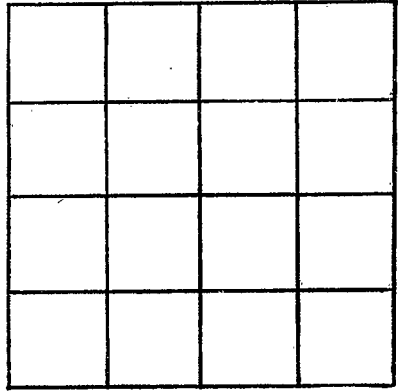

SECTION _____

Please indicate well location X.

ADDITIONAL INFORMATION

A series of horizontal lines for recording additional information, starting below the 'ADDITIONAL INFORMATION' header and extending to the bottom of the page.

If more than one screen, show locations of each on sketch.