

LOWNDES
 F2013
 5-18-78

MISSISSIPPI
 BOARD OF WATER COMMISSIONERS
 416 North State Street
 Jackson, Mississippi 39201

WATER WELL DRILLERS LOG


May 18 1978 date well completed
 Mid-South Drilling Co. firm name
 Lowndes county well located

LANDOWNER:	description of formations encountered	from	to
Dr. F. B. Wiggall 152 J. McCray Rd. Columbus, Ms. 39701 (mailing address)	clay	0	215
	sand	215	236
WELL LOCATION: sec. 18 T. 19 N R. 17 E 5 miles W of Columbus (distance) (direction) (nearest town)	clay	236	240
	sand	240	270
WELL PURPOSE: (home, irrigation, municipal, industrial)	clay	270	281
WELL COMPLETION DATA:	sand	281	285
(1) diameter (inches) 4	clay	285	295
(2) total depth (feet) 390	sand	295	300
(3) static water level (feet) 110 below top of ground.	clay	300	310
(4) casing pvc (material) 180 (depth)	sand	310	315
(size) If telescope see back.	clay	315	338
(5) screen none (length) (depth to top)	clay	338	337
(size) (material)	sand	337	360
(6) pump 1 1/2 (HP) 18 (yield gpm)	sand	360	387
electric (type power)	clay	387	390
(7) electric log no (yes or no)			
(organization running log)			
(8) how well bottom plugged Open			
DRILLERS REMARKS:			

RECEIVED
 AUG 10 1978
 MISS. BD. OF WATER COM.

If well telescopes please sketch and show depths.

GROUND LEVEL

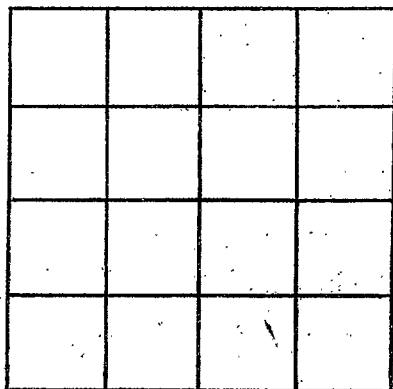

SECTION _____

Please indicate well location X.

ADDITIONAL INFORMATION

If more than one screen, show locations of each on sketch.