

LOWNDES
 F2015
 7-27-78

MISSISSIPPI
 BOARD OF WATER COMMISSIONERS
 416 North State Street
 Jackson, Mississippi 39201

WATER WELL DRILLERS LOG

July 27, 1978 Mid-South Drilling Co. Lowndes
 date well completed firm name county well located


LANDOWNER: <u>W. C. Downing</u>	description of fomations encountered	from	to
<u>1220 12th Street North</u>			
<u>Columbus, MS 39701</u> (mailing address)	<u>clay</u>	<u>30</u>	<u>165</u>
<u>WELL LOCATION:</u>	<u>clay & sand</u>	<u>165</u>	<u>285</u>
sec. <u>29</u> T. <u>17</u> N. R. <u>18</u> E.	<u>clay</u>	<u>285</u>	<u>293</u>
<u>4</u> miles west of <u>Columbus</u>	<u>sand & clay streaks</u>	<u>293</u>	<u>315</u>
(distance) (direction) of (nearest town)	<u>sand</u>	<u>315</u>	<u>320</u>
<u>WELL PURPOSE: home</u> (home, irrigation, municipal, industrial)	<u>clay</u>	<u>320</u>	<u>325</u>
<u>WELL COMPLETION DATA:</u>	<u>clay</u>	<u>325</u>	<u>340</u>
(1) diameter (inches) <u>4</u>	<u>clay</u>	<u>340</u>	<u>345</u>
(2) total depth (feet) <u>345</u>			
(3) static water level (feet) <u>120</u> below top of ground.			
(4) casing <u>PVC</u> <u>160</u> (material) (depth)			
(size) If telescope see back.			
(5) screen <u>screen none</u> (length) (depth to top)			
(size) (material)			
(6) pump <u>3/4</u> <u>10</u> (HP) (yield gpm)			
<u>electric</u> (type power)			
(7) electric log <u>none</u> (yes or no)			
(organization running log)			
(8) how well bottom plugged <u>open</u>			
<u>DRILLERS REMARKS:</u>			

RECEIVED
 AUG 10 1978

MISS. BD. OF WATER COMM.

If well telescopes please sketch and show depths.

GROUND LEVEL

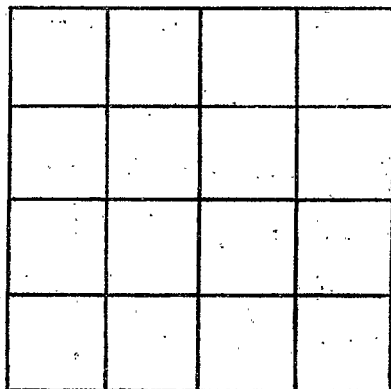

SECTION _____

Please indicate well location X.

ADDITIONAL INFORMATION

If more than one screen, show locations of each on sketch.