

LOWNDES

F 2017

11-2-78

MISSISSIPPI
 BOARD OF WATER COMMISSIONERS
 416 North State Street
 Jackson, Mississippi 39201

WATER WELL DRILLERS LOG

Nov. 2 1978 Mid-South Drilling Loundes
 date well completed firm name county well located

LANDOWNER: Jimmy Talley	description of formations encountered	from	to
Route 3 Box 219 Columbus Ms 39701 (mailing address)			

WELL LOCATION:
 sec. 10 T. 19^N R. 17 E
 S
 1 miles NW of Col.
 (distance) (direction) (nearest town)

rock at 127' & 127'

WELL PURPOSE: Home
 (home, irrigation, municipal, industrial)

- WELL COMPLETION DATA:
- (1) diameter (inches) 4 3/4"
 - (2) total depth (feet) 375'
 - (3) static water level (feet) 75' below top of ground.
 - (4) casing PVC 100
 (material) (depth)
 (size) If telescope see back.
 - (5) screen none
 (length) (depth to top)
 (size) (material)
 - (6) pump 3/4 15
 (HP) (yield gpm)
 electric
 (type power)
 - (7) electric log no
 (yes or no)
 no
 (organization running log)
 - (8) how well bottom plugged open


RECEIVED
 NOV 16 1978

MISS. BD. OF WATER COMMISSIONERS

DRILLERS REMARKS:

If well telescopes please sketch and show depths.

GROUND LEVEL

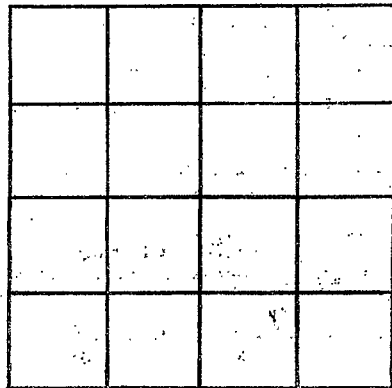

SECTION _____

Please indicate well location X.

ADDITIONAL INFORMATION

If more than one screen,
show locations of each on sketch.