

LOWDES

F 2019

11-18-78

MISSISSIPPI  
 BOARD OF WATER COMMISSIONERS  
 416 North State Street  
 Jackson, Mississippi 39201

WATER WELL DRILLERS LOG

Nov. 18 1978 Mid-South Drilg. Lowdes  
 date well completed firm name county well located


LANDOWNER: S.F. Williams Rt. 3 Box 184 Columbus, MS 39701 (mailing address)	description of formations encountered	from	to
	Sand + gravel	10	35
	clay & sand	35	145
	sand	145	150
	clay & sand	150	221
	sand	221	239
	clay	239	240
	clay & sand	240	255
	clay	255	268
	sand	268	270
	clay	270	285
<b>WELL LOCATION:</b> sec. 25 T 19 N R 10 E 2 miles west of Col. (distance) (direction) (nearest town)			
<b>WELL PURPOSE:</b> <u>landmark</u> (home, irrigation, municipal, industrial)			
<b>WELL COMPLETION DATA:</b>			
(1) diameter (inches) <u>4"</u>			
(2) total depth (feet) <u>285</u>			
(3) static water level (feet) <u>30</u> below above top of ground.			
(4) casing <u>PVC, 60</u> (material) (depth) <u>4"</u> (size) if telescope see back.			
(5) screen <u>none</u> (length) (depth to top) (size) (material)			
(6) pump <u>none</u> (HP) (yield gpm) (type power)			
(7) electric log <u>no</u> (yes or no) <u>no</u> (organization running log)			
(8) how well bottom plugged <u>open</u>			
DRILLERS REMARKS:			

RECEIVED  
 NOV 27 1978

MISS. BD. OF WATER COMM.

If well telescopes please sketch and show depths.

GROUND LEVEL

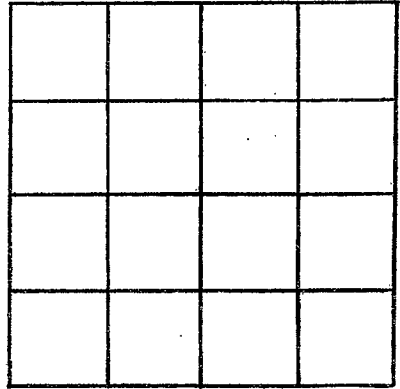

SECTION \_\_\_\_\_

Please indicate well location X.

ADDITIONAL INFORMATION

If more than one screen, show locations of each on sketch.