

LOWNDES
F 2020
5-2-79

MISSISSIPPI
 BOARD OF WATER COMMISSIONERS
 416 North State Street
 Jackson, Mississippi 39201

WATER WELL DRILLERS LOG

5/2 1979 Albino Drilling Inc. Lowndes
 date well completed firm name county well located

LANDOWNER: Hosie Foster
1303 6th St. S.
Columbus, Ms. 39701
 (mailing address)

description of formations encountered	from	to
Top Soil	0	10'
Lime Rock	10'	300'
1 st SAND	300'	350'
Muck	350'	390'
2 nd SAND	390'	500'

WELL LOCATION:
 sec 32 T 19 N R 17 E
5 miles SW of Columbus
 (distance) (direction) (nearest town)

WELL PURPOSE: Church
 (home, irrigation, municipal, industrial)

- WELL COMPLETION DATA:
- (1) diameter (inches) 4" x 2"
 - (2) total depth (feet) 500'
 - (3) static water level (feet) 58 below top of ground.
 - (4) casing 4" Plastic, 30'
 (material) (depth)
4" x 2"
 (size) if telescope see back.
 - (5) screen 30', 420'
 (length) (depth to top)
4" x 2", Plastic
 (size) (material)
 - (6) pump 1/2 10
 (HP) (yield gpm)
Electric
 (type power)
 - (7) electric log NO
 (yes or no)
 (organization running log)
 - (8) how well bottom plugged CAP

Miss. Board of Water Comm.

JUN 20 1979


RECEIVED

DRILLERS REMARKS:

If well telescopes please sketch and show depths.

GROUND LEVEL

80'
4" casing

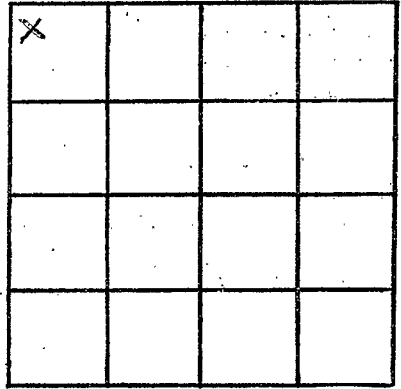

SECTION 32

Please indicate well location X.

ADDITIONAL INFORMATION

160'
2" casing
30' 2" Comm. Screen

If more than one screen, show locations of each on sketch.