

Received
DNR
9/24/79

Lowndes
F
2022
8-22-79

MISSISSIPPI
BOARD OF WATER COMMISSIONERS
416 North State Street
Jackson, Mississippi 39201


WATER WELL DRILLERS LOG

8-22 date well completed 1979 Mid South Drilling firm name Lowndes county well located

LANDOWNER <u>Harry Melton</u>	description of formations encountered	from	to
<u>Columbus MS</u> (mailing address)	clay	0	60
WELL LOCATION: sec <u>30</u> T <u>19</u> N R <u>17</u> E S W	clay & sand	60	128
6 miles <u>N</u> of <u>Col</u> (distance) (direction) (nearest town)	sand	128	145
WELL PURPOSE: <u>home</u> (home, irrigation, municipal, industrial)	clay	145	150
WELL COMPLETION DATA:	clay & sand	150	210
(1) diameter (inches) <u>4"</u>	Rock at 93' & 98'		
(2) total depth (feet) <u>210</u>			
(3) static water level (feet) <u>40</u> below top of ground.			
(4) casing <u>PVC</u> , <u>40</u> (material) (depth)			
<u>4"</u> (size) if telescope see back.			
(5) screen <u>no</u> (length) (depth to top)			
(size) (material)			
(6) pump <u>no</u> (HP) (yield gpm)			
(type power)			
(7) electric log <u>no</u> (yes or no)			
<u>no</u> (organization running log)			
(8) how well bottom plugged <u>open</u>			
DRILLERS REMARKS:			

If well telescopes please sketch and show depths.

GROUND LEVEL

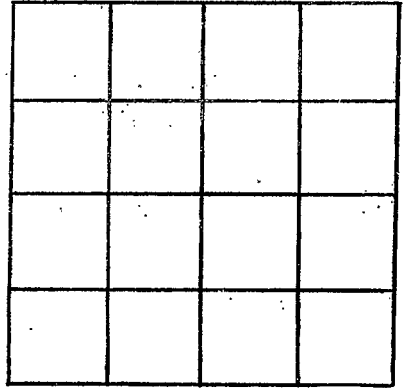

SECTION _____

Please indicate well location X.

ADDITIONAL INFORMATION

If more than one screen,
show locations of each on sketch.