

Lowndes
F 2023
12-3-79

MISSISSIPPI
 BOARD OF WATER COMMISSIONERS
 416 North State Street
 Jackson, Mississippi 39201

WATER WELL DRILLERS LOG

12-3 date well completed 1979 Mid South Drilling firm name Lowndes county well located

LANDOWNER: Sebor Cook
2002 4th Ave N
Columbus MS 39701
 (mailing address)

description of formations encountered	from	to
clay	0	10
sand	10	23
clay	23	165
clay & sand	165	300

WELL LOCATION:
 sec. 8 T. 19 R. 17
2 1/2 miles NW of Columbus
 (distance) (direction) (nearest town)

Back at 198'
 245'
 250'
 & 293'

WELL PURPOSE:
 (home, irrigation, municipal, industrial)

- WELL COMPLETION DATA:
- diameter (inches) 6
 - total depth (feet) 300
 - static water level (feet) 23 below top of ground.
 - casing PVC, 200 (material), (depth)
6" (size) if telescope see back.
 - screen N/A (length), (depth to top)
 (size) (material)
 - pump N/A (HP), (yield gpm)
 (type power)
 - electric log NO (yes or no)
NO (organization running log)
 - how well bottom plugged open

DEPT. OF NATURAL RESOURCES
 BUREAU OF LAND & WATER RESOURCES


JAN 7 1980

RECEIVED

DRILLERS REMARKS:

If well telescopes please sketch and show depths.

GROUND LEVEL

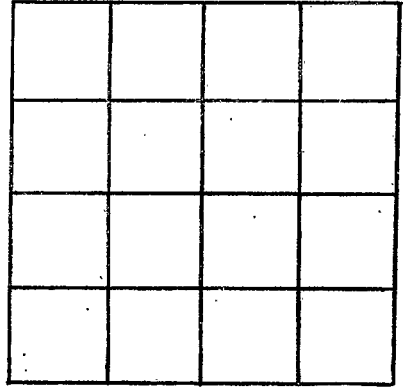

SECTION _____

Please indicate well location X.

ADDITIONAL INFORMATION

If more than one screen,
show locations of each on sketch.