

Lowndes

F 2024

7/1/80

MISSISSIPPI BOARD OF WATER COMMISSIONERS  
416 North State Street  
Jackson, Mississippi 39201

WATER WELL DRILLERS LOG

July 1 1980 MidSouth Drilling Lowndes  
date well completed firm name county well located

LANDOWNER	Description of formations encountered	from	to
William Williams	clay	0	195
Columbus, MS 39701 (mailing address)	clay & sand	195	345
WELL LOCATION: sec. 31 T. <del>1</del> R. 17 E 5 19 N W of Col. (distance) (direction) (nearest town)	clay	345	360
WELL PURPOSE: Home (home, irrigation, municipal, industrial)			
WELL COMPLETION DATA:			
(1) diameter (inches) 4			
(2) total depth (feet) 360			
(3) static water level (feet) 140 below top of ground.			
(4) casing PVC, 60 (material), (depth)			
4 (size) if telescope see back.			
(5) screen NO, (length) (depth to top)			
(size) (material)			
(6) pump 1/2 (HP), 5 (yield gpm)			
electric (type power)			
(7) electric log NO (yes or no)			
NO (organization running log)			
(8) how well bottom plugged open			
DRILLERS REMARKS:			


DEPT. OF NATURAL RESOURCES  
BUREAU OF LAND & WATER RESOURCES

AUG 6 1980

RECEIVED

If well telescopes please sketch and show depths.

GROUND LEVEL

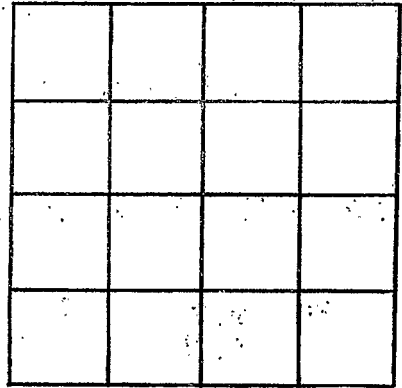

SECTION \_\_\_\_\_

Please indicate well location X.

ADDITIONAL INFORMATION

If more than one screen,  
show locations of each on sketch.