

MISSISSIPPI DEPARTMENT OF NATURAL RESOURCES

Bureau of Land and Water Resources

Southport Mall

P.O. Box 10631

Jackson, Mississippi 39209

WATER WELL DRILLERS LOG

LOWNDES
F 2026
8-27-81

8-27 1981 Clardy Well Drilling Lowndes
 date well completed firm name county well located

LANDOWNER: J. K. Sneed
140 1/2 11th Ave. No
Columbus, Miss.
 (mailing address)

WELL LOCATION:
 sec. 34 T. 19 N. R. 17 E.
4 1/2 miles SW of Colo.
 (distance) (direction) (nearest town)

WELL PURPOSE: Industrial
 (home, irrigation, municipal, industrial)

WELL COMPLETION DATA:

(1) diameter (inches) 6"
 (2) total depth (feet) 382'
 (3) static water level (feet) 110 below above top of ground.
 (4) casing PVC 170'
 (material) (depth)
4" if telescope see back.
 (size)
 (5) screen 2 0
 (length) (depth to top)
 (size) (material)
 (6) pump 3/4 900 gpm
 (HP) (yield gpm)
 (type power)
 (7) electric log _____
 (yes or no)
 (organization running log)
 (8) how well bottom plugged _____

description of formations encountered	depth	
	from	to
Hard Clay	9	57
soft clay	57	135
Sandy clay	135	139
soft clay	139	170
hard clay	170	176
soft clay	176	205
Sand	205	206
soft clay	206	220
hard clay	220	260
strata of sand	260	380
clay	380	385
sand	385	388
clay	388	390
sand	390	393
clay	393	394
sand	394	397
clay	397	308
sand	308	312
clay	312	319
sand	319	320 1/2
rock	320 1/2	322
clay	322	350
sand	350	380 1/2
clay	380 1/2	382

DEPT. OF NATURAL RESOURCES
 BUREAU OF LAND & WATER RESOURCES

SEP 15 1981


RECEIVED

DRILLERS REMARKS: _____

If well telescopes please sketch and show depths.


GROUND LEVEL

1970. 4"

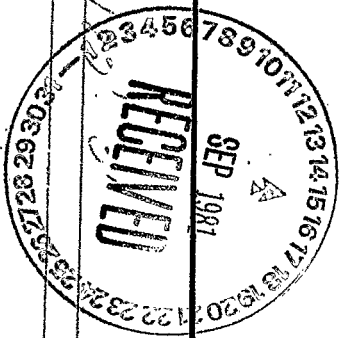

30' screen

If more than one screen, show locations of each on sketch.

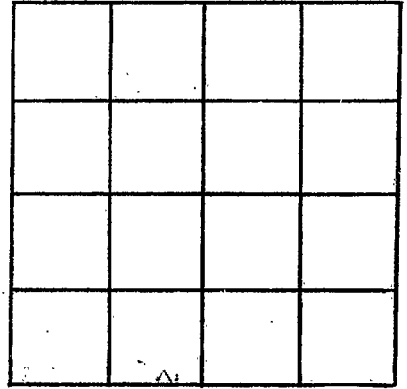

SECTION _____

Please indicate well location X.

ADDITIONAL INFORMATION

Multiple horizontal lines for providing additional information.