

MISSISSIPPI DEPARTMENT OF NATURAL RESOURCES

Bureau of Land and Water Resources

Southport Mall

P.O. Box 10631

Jackson, Mississippi 39209

WATER WELL DRILLERS LOG

LOWNDES
F 227
9-10-81

9-10-81 date well completed 1981 Clardy Well Drilling Lowndes firm name county well located

LANDOWNER: Charles Younger
 P.O. Box 303
 Columbus, Miss
 (mailing address)

WELL LOCATION:
 sec. 29 T. 19 N. R. 17 E
 6 miles W of Colv.
 (distance) (direction) (nearest town)

WELL PURPOSE: home
 (home, irrigation, municipal, industrial)

- WELL COMPLETION DATA:
- (1) diameter (inches) 4"
 - (2) total depth (feet) 320
 - (3) static water level (feet) 75' below top of ground.
 - (4) casing PVC 144'
 (material) (depth)
 (size) if telescope see back.
 - (5) screen
 (length) (depth to top)
 (size) (material)
 - (6) pump 1/2 800 gph
 (HP) (yield gph)
 (type power)
 - (7) electric log (yes or no)
 (organization running log)
 - (8) how well bottom plugged


description of formations encountered	from	to
Clay	0	130
Rock	130	
Clay	130	182
Sandy clay	132	182
good sand streaks	182	190
Rock	187	
Sandy streaks	190	200
Good sand	200	210
Sandy clay	210	255
hard clay	255	285
Sandy streaks	285	291
hard clay	291	302
soft blue clay	302	320

DEPARTMENT OF NATURAL RESOURCES
 BUREAU OF LAND AND WATER RESOURCES
 RECEIVED
 OCT 28 1981

DRILLERS REMARKS:

If well telescopes please sketch and show depths.

GROUND LEVEL

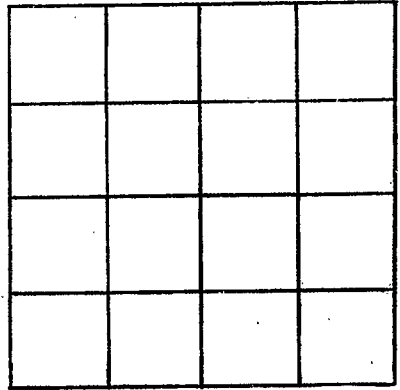

SECTION _____

Please indicate well location X.

ADDITIONAL INFORMATION

If more than one screen, show locations of each on sketch.

REC-118
A 8:42
8216018