

MISSISSIPPI DEPARTMENT OF NATURAL RESOURCES
Bureau of Land and Water Resources
 Southport Mall
 P.O. Box 10631
 Jackson, Mississippi 39209
WATER WELL DRILLERS LOG

Lowndes
F
2031

4-21-1983 Clardy Well Drilling Lowndes
 date well completed firm name county well located

LANDOWNER: Harold Hobbs
Old West Point Rd.
Columbus, Miss.
 (mailing address)

WELL LOCATION:
 sec. 15 T. 19 N. R. 17 E
4 miles (distance) (direction) of Calhoun (nearest town)

WELL PURPOSE: home
 (home, irrigation, municipal, industrial)

WELL COMPLETION DATA:

- (1) diameter (inches) 4"
- (2) total depth (feet) 341'
- (3) static water level (feet) 70 below above top of ground.
- (4) casing PVC 183 1/2'
 (material) (depth)
 (size) if telescope see back.
- (5) screen 30' (length) (depth to top)
2" (size) PVC (material)
- (6) pump 1 1250 gph.
 (HP) (yield gph)
elec. (type power)
- (7) electric log no
 (yes or no)
 (organization running log)
- (8) how well bottom plugged _____

description of formations encountered	from	to
red clay	0	18
blue clay	18	74
sandy clay	74	100
rock	100	101
sandy clay	101	140
rock	140	142
sand	142	154
sandy clay	154	165
rock	165	166
sandy clay	166	176
good clay	176	192
hard clay	192	210
sandy clay	210	218
sand	218	247
clay	247	278
gumboey clay	278	311
sand	311	327
clay	327	341

DEPT. OF NATURAL RESOURCES
 BUREAU OF LAND & WATER RESOURCES



MAY 10 1983

RECEIVED

DRILLERS REMARKS: _____

If well telescopes please sketch and show depths.

GROUND LEVEL

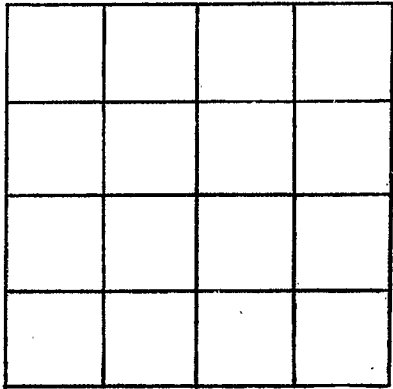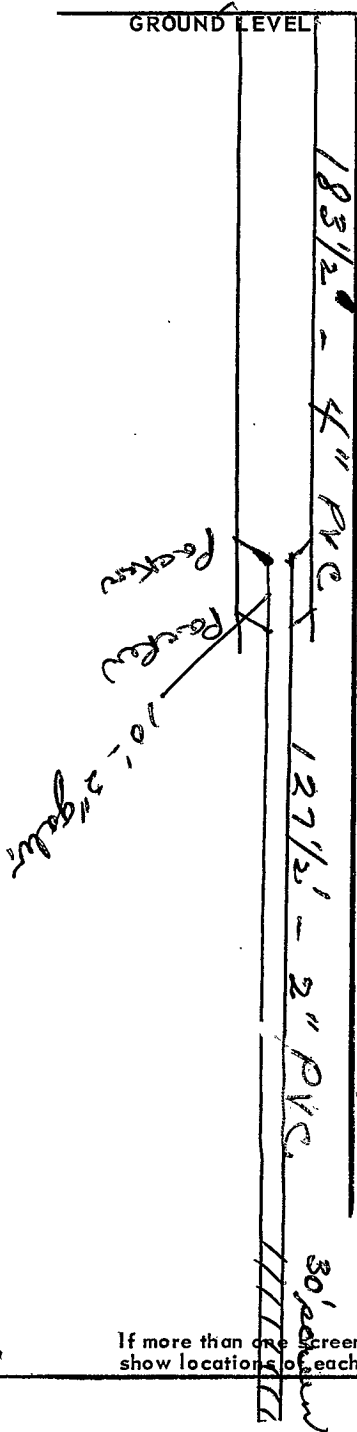

SECTION _____

Please indicate well location X.

ADDITIONAL INFORMATION

A series of horizontal lines for providing additional information.

If more than one screen, show locations of each on sketch.