

MISSISSIPPI DEPARTMENT OF NATURAL RESOURCES

Bureau of Land and Water Resources

Southport Mall

P.O. Box 10631

Jackson, Mississippi 39209

WATER WELL DRILLERS LOG

Landers
F
2032

6-24 date well completed Clardy Well Drilling firm name Landers county well located

LANDOWNER: Greg Davidson
1208 3rd Ave No
Columbus, Miss
(mailing address)

WELL LOCATION:
sec 37 T 19 N R 17 E
4 miles SE of Colo.
(distance) (direction) (nearest town)

WELL PURPOSE:
(home, irrigation, municipal, industrial)

- WELL COMPLETION DATA:
- (1) diameter (inches) 4"
 - (2) total depth (feet) 236'
 - (3) static water level (feet) 110' below top of ground.
 - (4) casing PVC, 164"
(material) (depth)
4"
(size) if telescope see back.
 - (5) screen 25'
(length) (depth to top)
2" PVC
(size) (material)
 - (6) pump 3/4 850 gph.
(HP) (yield gpm)
 - elec
(type power)
 - (7) electric log No
(yes or no)
 - (organization running log)
 - (8) how well bottom plugged

description of formations encountered	from	to
red clay	0	15
sand & gravel	15	40
blue clay	40	66
sandy clay	66	75
hard blue clay	75	88
sandy clay	88	109
good clay	109	138
sandy clay	138	141
rock	141	142
blue clay	142	143
rock	143	144
blue clay	144	165
sand	165	172
clay	172	174
good sand	174	181
clay	181	186
good sand	186	190
hard clay	190	218
good clay sand	218	234
clay	234	236

DEPT. OF NATURAL RESOURCES
BUREAU OF LAND & WATER RESOURCES

JUL 28 1983

RECEIVED

DRILLERS REMARKS:


If well telescopes please sketch and show depths.

GROUND LEVEL

164' - 4"

50' - 2"

20' Screen

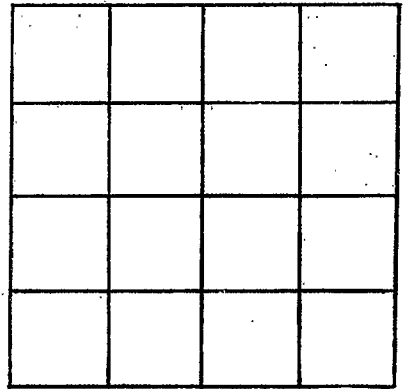

SECTION _____

Please indicate well location X.

ADDITIONAL INFORMATION

If more than one screen, show locations of each on sketch.