

MISSISSIPPI DEPARTMENT OF NATURAL RESOURCES

Bureau of Land and Water Resources

Southport Mall

P.O. Box 10631

Jackson, Mississippi 39209

WATER WELL DRILLERS LOG

LOWNDES  
F 2034

6-5-84 19 Clardy Well Drilling Lowndes  
date well completed firm name county well located

LANDOWNER: J.K. Ince Const.  
1402 11th Ave. No.  
Columbus, MS  
(mailing address)

WELL LOCATION:  
sec. 22 T. 19 N. R. 17 E  
7 miles W of Calhoun  
(distance) (direction) (nearest town)

WELL PURPOSE: agricultural  
(home, irrigation, municipal, industrial)

- WELL COMPLETION DATA:
- (1) diameter (inches) 4"
  - (2) total depth (feet) 262'
  - (3) static water level (feet) 118' below above top of ground.
  - (4) casing PVC 196'  
(material) (depth)  
4"  
(size) if telescope see back.
  - (5) screen 30'  
(length) (depth to top)  
2" PVC  
(size) (material)
  - (6) pump 3/4 1000 gpd.  
(HP) (yield gpm)  
elec.  
(type power)
  - (7) electric log no  
(yes or no)  
  
(organization running log)
  - (8) how well bottom plugged \_\_\_\_\_

description of formations encountered	from	to
<u>brown clay</u>	<u>0</u>	<u>10</u>
<u>grey lime rock</u>	<u>10</u>	<u>12</u>
<u>blue clay</u>	<u>12</u>	<u>22</u>
<u>lime rock</u>	<u>22</u>	<u>32</u>
<u>hard blue clay</u>	<u>32</u>	<u>162</u>
<u>sandy clay</u>	<u>162</u>	<u>190</u>
<u>good clay</u>	<u>190</u>	<u>199</u>
<u>rock 6"</u>	<u>199</u>	<u>199 1/2</u>
<u>sandy clay</u>	<u>199 1/2</u>	<u>218 1/2</u>
<u>rock</u>	<u>218 1/2</u>	<u>219 1/2</u>
<u>sand</u>	<u>219 1/2</u>	<u>253 1/2</u>
<u>rock</u>	<u>253 1/2</u>	<u>254</u>
<u>sand</u>	<u>254</u>	<u>260</u>
<u>clay</u>	<u>260</u>	<u>262</u>


DEPT. OF NATURAL RESOURCES  
BUREAU OF LAND & WATER RESOURCES

JUL 11 1984  
RECEIVED

DRILLERS REMARKS:

If well telescopes please sketch and show depths.

GROUND LEVEL

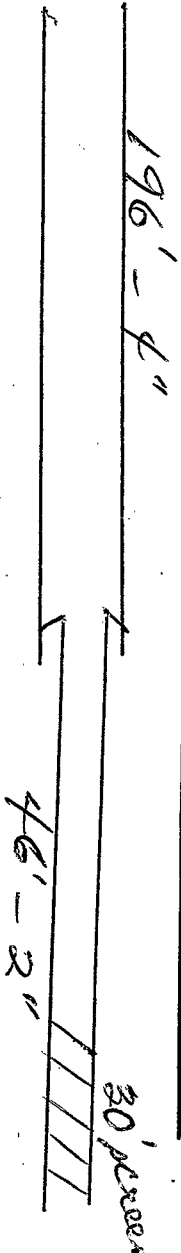

If more than one screen, show locations of each on sketch.

4x4 grid table for well location

SECTION \_\_\_\_\_

Please indicate well location X.

ADDITIONAL INFORMATION

Table with 2 columns and 15 rows for additional information