

**MISSISSIPPI
BOARD OF WATER COMMISSIONERS**
416 North State Street
Jackson, Mississippi 39201

L

WATER WELL DRILLERS LOG

Lowndes
F 2036
4-9-85

April 9 1985 Mid South Drilling Company Lowndes
date well completed firm name county well located

LANDOWNER: Dr. Wigyl
P. O. Drawer 2506
Columbus MS 39701
(mailing address)

description of formations encountered	from to	
	from	to
clay	0-	105
clay and sand	105	255
sand	255	270
clay and sand	270	340
sand	340	370

WELL LOCATION:
sec. 17 T 19 N R 17 E
6 miles W of Columbus
(distance) (direction) (nearest town)

WELL PURPOSE: home
(home, irrigation, municipal, industrial)

WELL COMPLETION DATA:

(1) diameter (inches) 4"

(2) total depth (feet) 370'

(3) static water level (feet) 120 below ~~xxxxx~~ top of ground.

(4) casing PVC 340'
(material) (depth)
4" If telescope see back.
(size)

(5) screen 30' 340'
(length) (depth to top)
4" PVC .032
(size) (material)

(6) pump no
(HP) (yield-gpm)
(type power)

(7) electric log no
(yes or no)
no
(organization running log)

(8) how well bottom plugged screen


RECEIVED
JUL 19 1985

DRILLERS REMARKS:

Department of Natural Resources
Bureau of Land & Water Resources

If well telescopes please sketch and show depths.

GROUND LEVEL

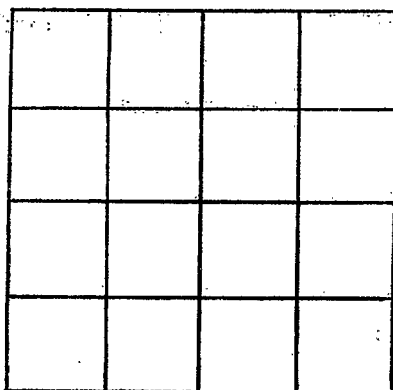

SECTION _____

Please indicate well location X.

ADDITIONAL INFORMATION

If more than one screen, show locations of each on sketch.