

MISSISSIPPI DEPARTMENT OF NATURAL RESOURCES

Bureau of Land and Water Resources

Southport Mall

P.O. Box 10631

Jackson, Mississippi 39209

WATER WELL DRILLERS LOG

LOWNDES  
F  
2037

5-23-85  
date well completed

19 Clardy Well Drilling Lowndes  
firm name

county well located

LANDOWNER: L. Conn

Rt. 3 Box 258A

Cols. Ms.  
(mailing address)

description of formations encountered

from

to

Brown clay	0	20
lime rock	20	26
blue clay	26	36
lime rock	36	38 1/2
blue clay	38 1/2	130
40 ft sandy clay band	130	182
sandy clay	182	192
sand	192	202
clay	202	208
sandy clay	208	213
sand	213	241
clay	241	243
sand	243	266
clay	266	282
clay	282	300


WELL LOCATION:

sec. 28 T. 19 N. R. 17 E. S. W.  
5 miles W of Cols.  
(distance) (direction) (nearest town)

WELL PURPOSE: home  
(home, irrigation, municipal, industrial)

WELL COMPLETION DATA:

- (1) diameter (inches) 4"
- (2) total depth (feet) 300
- (3) static water level (feet) 75' below top of ground.
- (4) casing PVC, 220' (material) (depth)  
4" (size) if telescope see back.
- (5) screen (length) (depth to top)  
(size) (material)
- (6) pump 1/2 (HP) 850 (yield gpm) gphs  
elec (type power)
- (7) electric log no (yes or no)  
(organization running log)
- (8) how well bottom plugged

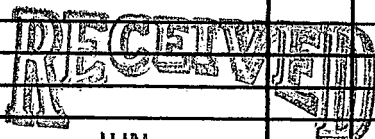


JUN 21 1985

DRILLERS REMARKS:

Department of Natural Resources  
Bureau of Land & Water Resources

If well telescopes please sketch and show depths.

GROUND LEVEL

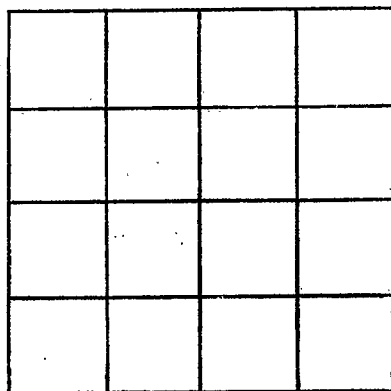

SECTION \_\_\_\_\_

Please indicate well location X.

ADDITIONAL INFORMATION

If more than one screen,  
show locations of each on sketch.