

MISSISSIPPI DEPARTMENT OF NATURAL RESOURCES

Bureau of Land and Water Resources

Southport Mall

P.O. Box 10631

Jackson, Mississippi 39209

WATER WELL DRILLERS LOG

Landowner
F
2038

12-13-85 date well completed 19 Clardy Well Drilling Landowner firm name county well located

LANDOWNER: Chuck Haynes
P.O. Box 9293
Columbus, MS
 (mailing address)

WELL LOCATION:
 sec. 34 T. 19 N. R. 17 E
4 miles W. of Colo.
 (distance) (direction) (nearest town)

WELL PURPOSE:
 (home, irrigation, municipal, industrial)

WELL COMPLETION DATA:

- (1) diameter (inches) 4"
- (2) total depth (feet) 280'
- (3) static water level (feet) 179' below above top of ground.
- (4) casing PVC, 264'
 (material) (depth)
 (size) if telescope see back.
- (5) screen 20', PVC
 (length) (depth to top)
 (size) (material)
- (6) pump 3/4, 900 gph.
 (HP) (yield gpm)
elec
 (type power)
- (7) electric log no
 (yes or no)
 (organization running log)
- (8) how well bottom plugged

description of formations encountered	from	to
red clay	0	8
hard lime rock	8	98
sandy blue clay	98	110
blue clay	110	120
rock	120	127
blue clay	127	137
rocky	137	147
sandy clay	147	168
rocky	168	180
blue clay	180	202
rock	202	203.6
sandy clay	203.6	212
rock	212	213
sandy clay	213	228
rock	228	229
rock	229	230
sandy clay	230	236
rock	236	237
sandy clay	237	244
fair clay	244	257
hard clay	257	270
rock	270	
sandy clay	270	276
sand	276	277
rock	277	
sand	277	280


RECEIVED
 FEB - 7 1986

DRILLERS REMARKS:

Department of Natural Resources
 Bureau of Land & Water Resources

If well telescopes please sketch and show depths.

GROUND LEVEL

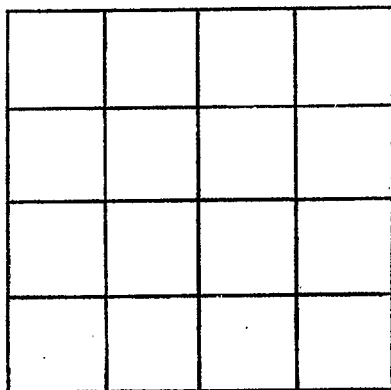

SECTION _____

Please indicate well location X.

ADDITIONAL INFORMATION

If more than one screen,
show locations of each on sketch.