

MISSISSIPPI DEPARTMENT OF NATURAL RESOURCES

Bureau of Land and Water Resources

P.O. Box 10631

Jackson, Mississippi 39209

WATER WELL DRILLERS LOG

COUNTY WELL LOCATED	
Harrison	
WELL NUMBER	CODED
F	
2040	
DATE WELL COMPLETED	
9/18	

PERMIT NUMBER
NAME OF DRILLING FIRM
Clardy Well, Dr.
Columbus, Mo

NAME & MAILING ADDRESS OF LANDOWNER			
Larry Bradford			
Old W. Point Rd.			
Columbus, Mo.			
WELL LOCATION:	SEC	TOWNSHIP	RANGE
	23	18 ^N _S	17 ^E _W
DISTANCE	DIRECTION	NEAREST TOWN	
3 Miles	W	Columbus	
OTHER LANDMARK			
WELL PURPOSE: Home, Irrigation, Municipal, Industrial, Fish Pond, etc.			
Home			

PUMP DATA			
PUMP TYPE (Circle One):			
<input checked="" type="radio"/> Submersible	<input type="radio"/> Turbine,	<input type="radio"/> Jet	<input type="radio"/> Flowing Well,
Other (Describe) _____			
POWER TYPE (Circle One):			
<input checked="" type="radio"/> Electric,	<input type="radio"/> Tractor,	<input type="radio"/> Diesel,	<input type="radio"/> Gasoline, Butane,
Other (Describe) _____			
Pump Capacity (GPM)	No. of Stages	Setting Depth	
900 ^H	9	100 FT.	
PUMP TEST			
Well yielded _____ 900 GPM with			
a drawdown of _____ ft.			
after _____ hours of pumping			

WELL DATA		
Well Depth	Casing Diameter (In.)	Casing Length (Ft.)
202	4"	146
Type of Casing	Hole Depth	Depth to Static Water Level
PVC		32'
TYPE OF COMPLETION: (Circle One or More):		
Gravel Packed, Underreamed, Telescoped, Natural Development, Open Hole, Other (Describe) _____		
Top of Lap Pipe or Reduction in Casing		
FEET		
IF TELESCOPED OR MORE THAN ONE SCREEN: USE BACK PAGE		

LOG DATA	
TYPE OF LOG RUN (Circle One):	
<input type="radio"/> No Log Run,	<input type="radio"/> Electric, Gamma Ray, Density, Sonic, Neutron,
Other (Describe) _____	
Name of Organization Running Log	

SCREEN DATA		
Diameter - Inches	Length - Feet	Slot Size - Inches
2"	26'	.013
Screen Type	Depth to Bottom Feet	
PVC		


GEOLOGIC DATA (Office Use Only)			
Surface Elev.	Geologic Unit	Unit Thickness	Depth to Top
Subs. SWL	Date	Analysis	Aquifer Test
Driller's Remarks			
OCT 13 1999			
Department of Natural Resources Bureau of Land & Water Resources			

DESCRIPTION OF FORMATIONS ENCOUNTERED	FROM	TO	FORMATIONS (Continued)	FROM	TO
Sandy br. clay	0	22	Fair clay	174 1/2	176 1/2
Rock	22	24	sandy	176 1/2	190
Sandy blue clay	24	49	(Rocky streaks)	190	193
Hard rock	49	49 1/2	clay	193	202
sandy clay	49 1/2	112			
Hard rock	112	113			
sandy clay	113	141			
Fair clay	141	151			
sandy clay	151	1106 1/2			
sm. rock	1106 1/2				
sandy clay	1106 1/2	174 1/2			

IF MORE SPACE IS NEEDED, USE BACK

If well telescopes please sketch and show depths.

GROUND LEVEL

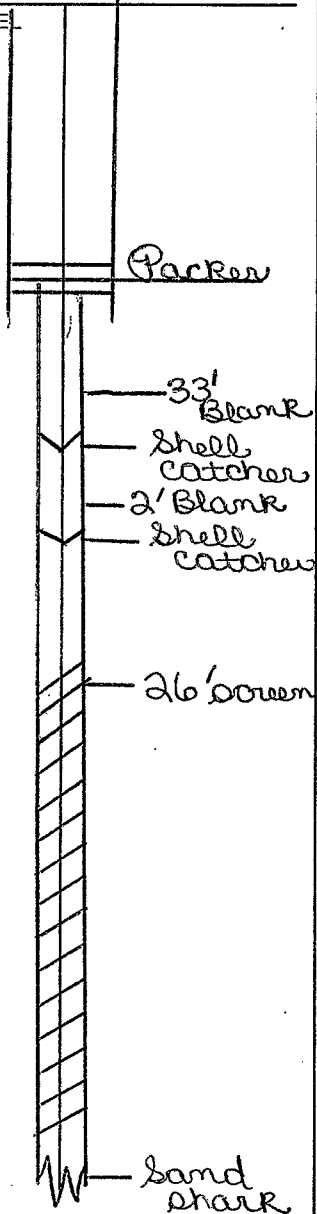

SECTION _____

Please indicate well location X.

ADDITIONAL INFORMATION

If more than one screen, show location of each on sketch.