

MISSISSIPPI DEPARTMENT OF NATURAL RESOURCES

Bureau of Land and Water Resources

P.O. Box 10631

Jackson, Mississippi 39209

WATER WELL DRILLERS LOG

COUNTY WELL LOCATED Boundaries	
WELL NUMBER F 2042	CODED
DATE WELL COMPLETED 6/16/88	

PERMIT NUMBER
NAME OF DRILLING FIRM Clardy Well Drill, Columbus, Mo.

NAME & MAILING ADDRESS OF LANDOWNER Mike Reese			
Rt. 3			
Columbus, Mo.			
WELL LOCATION: SEC	TOWNSHIP	RANGE	
8	19^N	17^E	
DISTANCE	DIRECTION	NEAREST TOWN	
6 1/2 Miles	West	of Columbus	
OTHER LANDMARK			
WELL PURPOSE: Home, Irrigation, Municipal, Industrial, Fish Pond, etc. Home			

PUMP DATA			
PUMP TYPE (Circle One): <input checked="" type="radio"/> Submersible <input type="radio"/> Turbine <input type="radio"/> Jet <input type="radio"/> Flowing Well, Other (Describe) _____			
POWER TYPE (Circle One): <input checked="" type="radio"/> Electric <input type="radio"/> Tractor <input type="radio"/> Diesel <input type="radio"/> Gasoline <input type="radio"/> Butane, Other (Describe) _____			
Pump Capacity (GPM)	No. of Stages	Setting Depth	
1,200	15	210' FT.	
PUMP TEST			
Well yielded 1,200 GPM with a drawdown of _____ ft. after _____ hours of pumping			

WELL DATA		
Well Depth 280'	Casing Diameter (In.) 4"	Casing Length (Ft.) 220'
Type of Casing PVC	Hole Depth	Depth to Static Water Level 91'
TYPE OF COMPLETION: (Circle One or More): <input type="checkbox"/> Gravel Packed, <input type="checkbox"/> Underreamed, <input type="checkbox"/> Telescoped, <input type="checkbox"/> Natural Development, <input type="checkbox"/> Open Hole, <input type="checkbox"/> Other (Describe) _____		
Top of Lap Pipe or Reduction in Casing		
FEET IF TELESCOPED OR MORE THAN ONE SCREEN: USE BACK PAGE		

LOG DATA	
TYPE OF LOG RUN (Circle One): <input type="checkbox"/> No Log Run, <input type="checkbox"/> Electric, <input type="checkbox"/> Gamma Ray, <input type="checkbox"/> Density, <input type="checkbox"/> Sonic, <input type="checkbox"/> Neutron, Other (Describe) _____	
Name of Organization Running Log	

SCREEN DATA		
Diameter - Inches 2"	Length - Feet 30'	Slot Size - Inches .013
Screen Type PVC		Depth to Bottom - Feet

GEOLOGIC DATA (Office Use Only)			
Surface Elev.	Geologic Unit	Unit Thickness	Depth to Top
Subs. SWL	Date	Analysis	Aquifer Test


Driller's Remarks JUL 19 1988
Department of Natural Resources Bureau of Land & Water Resources

DESCRIPTION OF FORMATIONS ENCOUNTERED	FROM	TO	FORMATIONS (Continued)	FROM	TO
Brown clay	0	20	Fair clay	217	231
Blue clay	20	85	sandy clay	231	238
sandy clay	85	115	fine sand	238	241
Rock	115	117	Rock (2")	241	241
sandy clay	117	177	sand	241	250
sandy clay	177	183 1/2	Hummy blue cl.	250	280
Rock	183 1/2	184			
sandy clay	184	190			
Fair clay	190	191 1/2			
Small, rock	191 1/2				
sandy clay	191 1/2	217			

IF MORE SPACE IS NEEDED, USE BACK

If well telescopes please sketch and show depths.

GROUND LEVEL

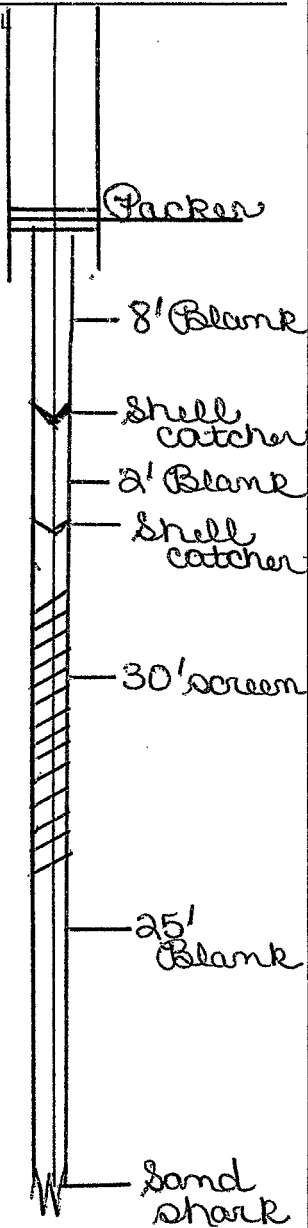

SECTION _____

Please indicate well location X.

ADDITIONAL INFORMATION

If more than one screen, show location of each on sketch.