

# MISSISSIPPI DEPARTMENT OF NATURAL RESOURCES

Bureau of Land and Water Resources

P.O. Box 10631

Jackson, Mississippi 39209

WATER WELL DRILLERS LOG

COUNTY WELL LOCATED <b>Leflore</b>	
WELL NUMBER <b>F 2043</b>	CODED
DATE WELL COMPLETED <b>6/28</b>	

PERMIT NUMBER
NAME OF DRILLING FIRM <b>Clardy Well Drill Columbus, Mo.</b>

NAME & MAILING ADDRESS OF LANDOWNER <b>Mr. Thomas Wolford Rt. 1 Box 270 Columbus, Mo. 39701</b>			
WELL LOCATION: SEC	TOWNSHIP	RANGE	
<b>5</b>	<b>19 N</b>	<b>17 E</b>	
DISTANCE <b>8</b> Miles	DIRECTION <b>South</b>	NEAREST TOWN <b>Columbus</b>	
OTHER LANDMARK <b>Home</b>			
WELL PURPOSE: Home, Irrigation, Municipal, Industrial, Fish Pond, etc. <b>Home</b>			

PUMP DATA		
PUMP TYPE (Circle One): <input checked="" type="radio"/> Submersible, <input type="radio"/> Turbine, <input type="radio"/> Jet <input type="radio"/> Flowing Well, Other (Describe) _____		
POWER TYPE (Circle One): <input checked="" type="radio"/> Electric, <input type="radio"/> Tractor, <input type="radio"/> Diesel, <input type="radio"/> Gasoline, <input type="radio"/> Butane, Other (Describe) _____		
Pump Capacity (GPM) <b>900</b>	No. of Stages <b>18</b>	Setting Depth <b>195</b> FT.
PUMP TEST: Well yielded <b>900</b> GPM with a drawdown of _____ ft. after _____ hours of pumping		

WELL DATA		
Well Depth <b>500'</b>	Casing Diameter (In.) <b>4"</b>	Casing Length (Ft.) <b>210'</b>
Type of Casing <b>PVC</b>	Hole Depth	Depth to Static Water Level <b>105'</b>
TYPE OF COMPLETION: (Circle One or More): <input type="radio"/> Gravel Packed, <input type="radio"/> Underreamed, <input type="radio"/> Telescoped, <input type="radio"/> Natural Development, <input type="radio"/> Open Hole, <input type="radio"/> Other (Describe) _____		
Top of Lap Pipe or Reduction in Casing  FEET <input type="checkbox"/> IF TELESCOPED OR MORE THAN ONE SCREEN: USE BACK PAGE		

LOG DATA	
TYPE OF LOG RUN (Circle One): <input type="radio"/> No Log Run, <input type="radio"/> Electric, <input type="radio"/> Gamma Ray, <input type="radio"/> Density, <input type="radio"/> Sonic, <input type="radio"/> Neutron, Other (Describe) _____	
Name of Organization Running Log	

SCREEN DATA		
Diameter - Inches <b>2"</b>	Length - Feet <b>50'</b>	Slot Size - Inches <b>.013</b>
Screen Type <b>PVC</b>		Depth to Bottom - Feet

GEOLOGIC DATA (Office Use Only)			
Surface Elev.	Geologic Unit	Unit Thickness	Depth to Top
Subs. SWL	Date	Analysis	Acidifer Test
<b>RECEIVED</b>			
Driller's Remarks  <b>JUL 19 1988</b>			
Bureau of Land and Water Resources Mississippi Department of Natural Resources			


DESCRIPTION OF FORMATIONS ENCOUNTERED	FROM	TO	FORMATIONS (Continued)	FROM	TO
Brown clay	0	22	Sandy clay	399	421
Blue clay	22	109	Sandy clay	421	442
Rock	109	110	(Casey clay)	435	442
Blue clay	110	178	Fine sand str.	442	472 1/2
Sandy clay	178	179 1/2	Blue clay	472 1/2	478
Blue clay	179 1/2	328	Fine sandy clay	478	481
Sandy clay	328	355	Rock	481	481 1/2
Rock	355	355 1/2	Clay	481 1/2	496
Sand	355 1/2	362	Blue clay	496	500
Fine sand	362	375			
Blue clay	375	399			

IF MORE SPACE IS NEEDED, USE BACK

If well telescopes please sketch and show depths.

---

GROUND LEVEL

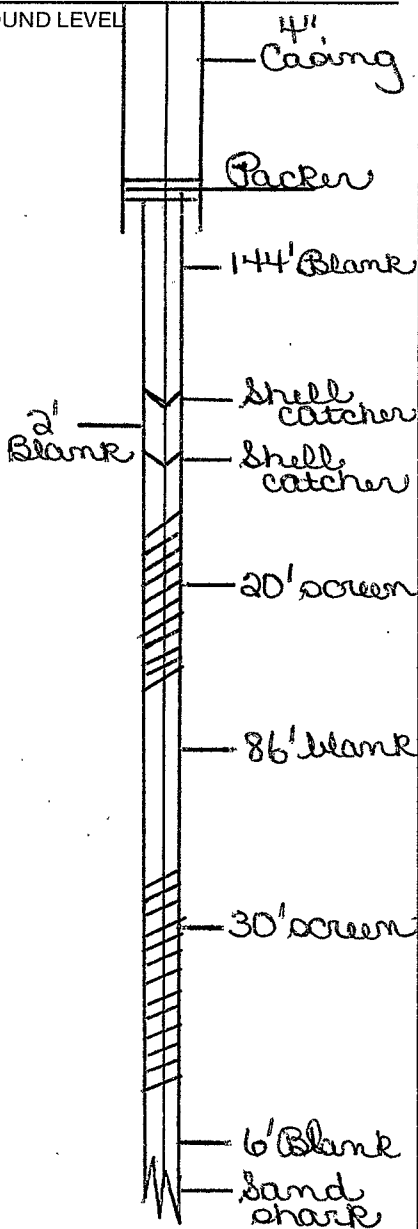


SECTION \_\_\_\_\_

Please indicate well location X.

ADDITIONAL INFORMATION

---

If more than one screen, show location of each on sketch.

---