

# MISSISSIPPI DEPARTMENT OF NATURAL RESOURCES

Bureau of Land and Water Resources

COUNTY WELL LOCATED <b>Forbes</b>	
WELL NUMBER <b>F 2044</b>	CODED
DATE WELL COMPLETED <b>9/19/88</b>	

PERMIT NUMBER
NAME OF DRILLING FIRM <b>Clardy Well Drill Columbus, Mo.</b>

P.O. Box 10631  
Jackson, Mississippi 39209  
**WATER WELL DRILLERS LOG**

NAME & MAILING ADDRESS OF LANDOWNER <b>Marvin Webb Old W. Point Rd. Columbus, Mo.</b>			
WELL LOCATION: SEC	TOWNSHIP	RANGE	
<b>22</b>	<b>19</b>	<b>N 17 E</b>	
DISTANCE	DIRECTION	NEAREST TOWN	
<b>4</b> Miles	<b>W</b>	of <b>Columbus</b>	
OTHER LANDMARK			
WELL PURPOSE: Home, Irrigation, Municipal, Industrial, Fish Pond, etc. <b>Home</b>			

<b>PUMP DATA</b>		
PUMP TYPE (Circle One): <input checked="" type="radio"/> Submersible, Turbine, Jet, Flowing Well, Other (Describe) _____		
POWER TYPE (Circle One): <input checked="" type="radio"/> Electric, Tractor, Diesel, Gasoline, Butane, Other (Describe) _____		
Pump Capacity (GPM) <b>900</b>	No. of Stages <b>12</b>	Setting Depth <b>140</b> FT.
PUMP TEST		
Well yielded <b>900</b> GPM <sup>#</sup> with a drawdown of _____ ft. after _____ hours of pumping		

<b>WELL DATA</b>		
Well Depth <b>222</b>	Casing Diameter (In.) <b>4"</b>	Casing Length (Ft.) <b>165</b>
Type of Casing <b>PVC</b>	Hole Depth	Depth to Static Water Level <b>55</b>
TYPE OF COMPLETION: (Circle One or More): Gravel Packed, Underreamed, Telescoped, Natural Development, Open Hole, Other (Describe) _____		
Top of Lap Pipe or Reduction in Casing		
FEET IF TELESCOPED OR MORE THAN ONE SCREEN: USE BACK PAGE		

<b>LOG DATA</b>	
TYPE OF LOG RUN (Circle One): No Log Run, Electric, Gamma Ray, Density, Sonic, Neutron, Other (Describe) _____	
Name of Organization Running Log	

<b>SCREEN DATA</b>		
Diameter - Inches <b>2</b>	Length - Feet <b>40'</b>	Slot Size - Inches <b>.013</b>
Screen Type <b>PVC</b>		Depth to Bottom - Feet


<b>GEOLOGIC DATA (Office Use Only)</b>			
Surface Elev.	Geologic Unit	Unit Thickness	Depth to Top
Subs. SWL	Date <b>NOV 8 1988</b>	Analysis	Adulter Test
Driller's Remarks			
<b>Department of Natural Resources Bureau of Land &amp; Water Resources</b>			

DESCRIPTION OF FORMATIONS ENCOUNTERED	FROM	TO	FORMATIONS (Continued)	FROM	TO
Brown clay	0	15	Sandstone	148	149
Grey clay	15	19	Fair clay	149	161
Blue clay	19	57	sandy clay	161	174
Grey sandstone	57	58	Fair clay	174	196
Sandy clay	58	89	Hummer sand streak	196	208
Sandstone	89	90	sand	208	218
Clay	90	91 1/2	Hummy clay	218	222
Sandstone	91 1/2	92			
Sandy clay	92	124			
Sandstone	124	125			
Sandy clay	125	148			

IF MORE SPACE IS NEEDED, USE BACK

If well telescopes please sketch and show depths.

GROUND LEVEL

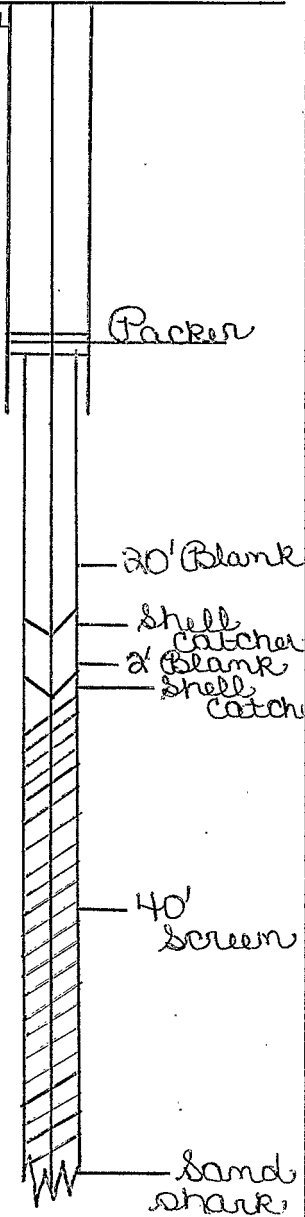


SECTION \_\_\_\_\_

Please indicate well location X.

ADDITIONAL INFORMATION

If more than one screen, show location of each on sketch.