

**MISSISSIPPI DEPARTMENT OF ENVIRONMENTAL QUALITY**

Office of Land and Water Resources

P. O. Box 10631  
Jackson, MS 39289-0631  
**WATER WELL DRILLERS LOG**

COUNTY WELL LOCATED <u>Bounded</u>	
WELL NUMBER <u>F 2054</u>	CODED
DATE WELL COMPLETED <u>10/8/93</u>	

PERMIT NUMBER
NAME OF DRILLING FIRM <u>Clardy Well Columbus, Ms</u>

NAME & MAILING ADDRESS OF LANDOWNER <u>McCrary - West</u>			
<u>P.O. Box 2402</u>			
<u>Columbus, Ms 39102</u>			
WELL LOCATION: SEC	TOWNSHIP	RANGE	
<u>1</u>	<u>19</u>	<u>17</u>	<u>E</u>
DISTANCE	DIRECTION	NEAREST TOWN	
<u>7 1/4</u> Miles	<u>S.W.</u> of	<u>Columbus</u>	
OTHER LANDMARK			
WELL PURPOSE: Home, Irrigation, Municipal, Industrial, Fish Pond, etc. <u>Home</u>			

PUMP DATA			
PUMP TYPE (Circle One): <u>Submersible</u> , Turbine, Jet, Flowing Well, Other (Describe)			
POWER TYPE (Circle One): <u>Electric</u> , Tractor, Diesel, Gasoline, Butane, Other (Describe) H/P <u>1/2</u>			
Pump Capacity (GPM) <u>900</u>	No. of Stages <u>9</u>	Setting Depth <u>80</u>	FT.
PUMP TEST			
Well yielded _____ GPM with a drawdown of _____ ft. after _____ hours of pumping			

WELL DATA		
Well Depth <u>258</u>	Casing Diameter (In.) <u>4"</u>	Casing Length (Ft.) <u>94</u>
Type of Casing <u>PVC</u>	Hole Depth	Depth to Static Water Level <u>41 1/2"</u>
TYPE OF COMPLETION: (Circle One or More): Gravel Packed, Underreamed, Telescoped, Natural Development, Open Hole, Other (Describe)		

LOG DATA	
TYPE OF LOG RUN (Circle One): No Log Run, Electric, Gamma Ray, Density, Sonic, Neutron, Other (Describe)	
Name of Organization Running Log	

WELL GROUTED TO A DEPTH OF _____ FEET
Type Grout (circle one): Cement, Bentonite, or Mix

GEOLOGIC DATA (Office Use Only)			
Surface Elev.	Geologic Unit	Unit Thickness	Depth to Top
Subs. SWL	Date	Analysis	Agguifer Test
Driller's Remarks			
<b>OCT 22 1993</b>			
Dept. of Environmental Quality Office of Land & Water Resources			


SCREEN DATA		
Diameter - Inches	Length - Feet	Slot Size - Inches
Screen Type	Depth to Bottom - Feet	

DESCRIPTION OF FORMATIONS ENCOUNTERED	FROM	TO	FORMATIONS (Continued)	FROM	TO
Brown clay	0	18	sand streak	203	209
Blue clay	18	97	sandy clay	209	230
sandy clay	97	110	lime sand	230	248
Rock	110	112	sandy clay	240	248
sandy clay	112	128	lumpy clay	248	258
lime sandy cl.	128	147			
Rock	147	147 1/2			
lime sandy clay	147 1/2	178			
Rock	178	179			
lime sandy clay	179	195			
sand	195	203			

IF MORE SPACE IS NEEDED, USE BACK

If well telescopes please  
sketch and show depths.

GROUND LEVEL

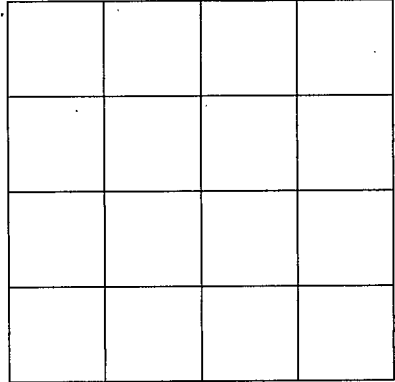

SECTION \_\_\_\_\_

Please indicate well location X.

ADDITIONAL INFORMATION

If more than one screen,  
show location of each on sketch.