

**MISSISSIPPI DEPARTMENT OF ENVIRONMENTAL
QUALITY**

Office of Land and Water Resources

P. O. Box 10631
Jackson, MS 39289-0631
WATER WELL DRILLERS LOG

COUNTY WELL LOCATED DeWitt	
WELL NUMBER F255	CODED
DATE WELL COMPLETED 5/16/94	

PERMIT NUMBER
NAME OF DRILLING FIRM Clardy Well Columbus, MS.

NAME & MAILING ADDRESS OF LANDOWNER Trinity Church 425 Military Rd. Columbus, MS 39701			
WELL LOCATION:	SEC	TOWNSHIP	RANGE
	31	19	N 17 E
DISTANCE	DIRECTION	NEAREST TOWN	
7 Miles	W.	of Columbus	
OTHER LANDMARK Church			
WELL PURPOSE: Home, Irrigation, Municipal, Industrial, Fish Pond, etc. Church			

PUMP DATA			
PUMP TYPE (Circle One): <u>Submersible</u> , Turbine, Jet, Flowing Well, Other (Describe) _____			
POWER TYPE (Circle One): <u>Electric</u> , Tractor, Diesel, Gasoline, Butane, Other (Describe) _____ H/P <u>1</u>			
Pump Capacity (GPM) 15	No. of Stages 15	Setting Depth 190 FT.	
PUMP TEST Well yielded _____ GPM with a drawdown of _____ ft. after _____ hours of pumping			

WELL DATA		
Well Depth 302	Casing Diameter (In.) 4"	Casing Length (Ft.) 200
Type of Casing PVC	Hole Depth 131'	Depth to Static Water Level 131'
TYPE OF COMPLETION: (Circle One or More): Gravel Packed, Underreamed, Telescoped, Natural Development, Open Hole, Other (Describe) _____		
WELL GROUTED TO A DEPTH OF _____ FEET Type Grout (circle one): Cement, Bentonite, or Mix		

LOG DATA	
TYPE OF LOG RUN (Circle One): No Log Run, Electric, Gamma Ray, Density, Sonic, Neutron, Other (Describe) _____	
Name of Organization Running Log	

SCREEN DATA		
Diameter - Inches 2"	Length - Feet 40'	Slot Size - Inches .013
Screen Type PVC	Depth to Bottom - Feet	


GEOLOGIC DATA (Office Use Only)			
Surface Elev.	Geologic Unit	Unit Thickness	Depth to Top
Subs. SWL	Date	Analysis	Aquifer Test
Driller's Remarks			
Top of Lap Pipe or Reduction in Casing			
FEET		IF TELESCOPED OR MORE THAN ONE SCREEN: USE BACK PAGE	

DESCRIPTION OF FORMATIONS ENCOUNTERED	FROM	TO	FORMATIONS (Continued)	FROM	TO
Brown clay	0	6			
sandy blue clay	6	32			
sandy clay	32	122			
clay	122	190			
Rocky clay	190	200			
sandy clay	200	202 1/2			
clay	202 1/2	217			
sandy clay	217	263			
Rocky sand streak	263	270 1/2			
rock	270 1/2	271 1/2			
sand	271 1/2	302			

RECEIVED
JUN 16 1994
Dept. of Environmental Quality
Office of Land & Water Resources

IF MORE SPACE IS NEEDED, USE BACK

If well telescopes please sketch and show depths.

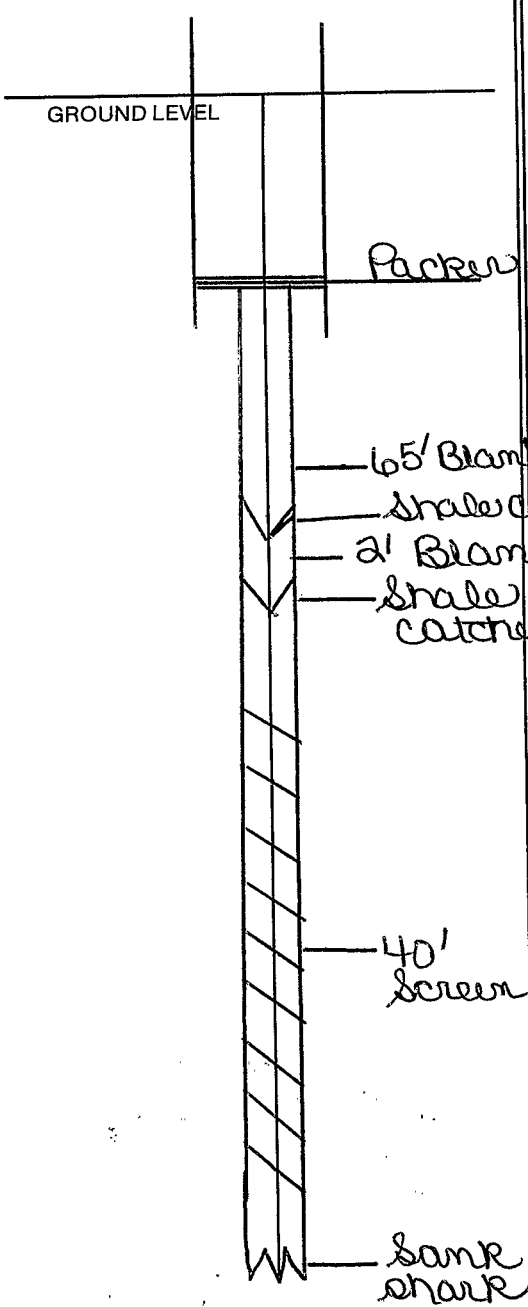

SECTION _____

Please indicate well location X.

ADDITIONAL INFORMATION

If more than one screen, show location of each on sketch.