

* Replaces 3034

MISSISSIPPI DEPARTMENT OF ENVIRONMENTAL QUALITY

Office of Land and Water Resources

P. O. Box 10631
Jackson, MS 39289-0631
WATER WELL DRILLERS LOG

COUNTY WELL LOCATED	
Lowndes	
WELL NUMBER	CODED
3034A *	
DATE WELL COMPLETED	
8-13-98	

PERMIT NUMBER
0-379
NAME OF DRILLING FIRM
F2069 Mid-South Drilling
Carrollton, AL

NAME & MAILING ADDRESS OF LANDOWNER			
Jim Williams			
510 15th. Ave. N			
Columbus, MS 39701			
WELL LOCATION:	SEC	TOWNSHIP	RANGE
	22	19 ^N _S	17 ^E _W
DISTANCE	DIRECTION		NEAREST TOWN
5 Miles	W		of Columbus
OTHER LANDMARK			
WELL PURPOSE: Home, Irrigation, Municipal, Industrial, Fish Pond, etc.			
Home			

PUMP DATA			
PUMP TYPE (Circle One):			
<input checked="" type="radio"/> Submersible	<input type="radio"/> Turbine	<input type="radio"/> Jet	<input type="radio"/> Flowing Well
Other (Describe) _____			
POWER TYPE (Circle One):			
<input checked="" type="radio"/> Electric	<input type="radio"/> Tractor	<input type="radio"/> Diesel	<input type="radio"/> Gasoline
<input type="radio"/> Butane	Other (Describe) _____		
H/P	1		
Pump Capacity (GPM)	No. of Stages	Setting Depth	
14	11	200 FT.	
PUMP TEST			
Well yielded _____ GPM with			
a drawdown of _____ ft.			
after _____ hours of pumping			


WELL DATA		
Well Depth	Casing Diameter (In.)	Casing Length (Ft.)
339'	4" x 2	296
Type of Casing	Hole Depth	Depth to Static Water Level
PVC	339	50'
TYPE OF COMPLETION: (Circle One or More):		
<input checked="" type="radio"/> Gravel Packed	<input type="radio"/> Underreamed	<input type="radio"/> Telescoped
<input type="radio"/> Natural Development	<input type="radio"/> Open Hole	<input type="radio"/> Other
(Describe) _____		
WELL GROUTED TO A DEPTH OF _____ FEET		
Type Grout (circle one): Cement, Bentonite, or Mix		

LOG DATA	
TYPE OF LOG RUN (Circle One):	
<input type="radio"/> Electric	<input checked="" type="radio"/> No Log Run
<input type="radio"/> Gamma Ray	<input type="radio"/> Density
<input type="radio"/> Sonic	<input type="radio"/> Neutron
Other (Describe) _____	
Name of Organization Running Log	


SCREEN DATA		
Diameter - Inches	Length - Feet	Slot Size - Inches
2	35	0.04 + 0.010
Screen Type	Depth to Bottom - Feet	
PVC and SS		

GEOLOGIC DATA (Office Use Only)			
Surface Elev.	Geologic Unit	Unit Thickness	Depth to Top
Subs. SWL	Date	Analysis	Aquifer Test
Driller's Remarks			
Top of Lap Pipe or Reduction in Casing			
FEET		IF TELESCOPED OR MORE THAN ONE SCREEN: USE BACK PAGE	

DESCRIPTION OF FORMATIONS ENCOUNTERED	FROM	TO
Clay	300	309
Sand	309	312
clay	312	313
Sand	313	320
Sand	320	331
Clay	331	332
Sand	332	334
Clay	334	335
clay	335	339

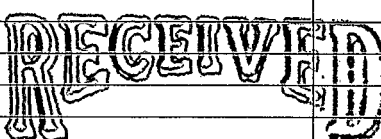FORMATIONS (Continued)	FROM	TO
 DEC 14 1998 Dept of Environmental Quality Office of Land & Water Resources		
IF MORE SPACE IS NEEDED, USE BACK		

If well telescopes please sketch and show depths.

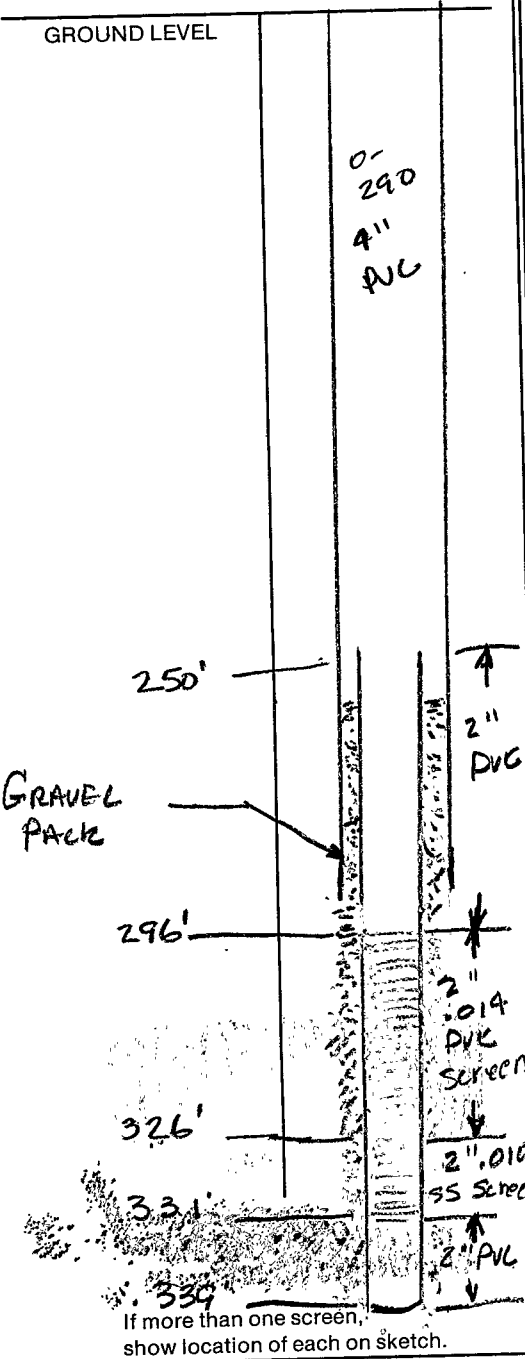

SECTION _____

Please indicate well location X.

ADDITIONAL INFORMATION

If more than one screen,
show location of each on sketch.