

HG ~~721~~  
10-29-60

WATER WELL DRILLERS LOG

Date: 10-29, 1960, Driller: W. J. REEVES & SON County LOWNDES

13617

(Name)

(1) Owner of Land: WILLIAM BONNER  
(Name)  
COLUMBUS MISS  
(Address)

(2) Location: 1/4, 1/4, Sec. 35 T8R18W  
4 miles E of COLUMBUS  
(distance) (direction) (Nearest Town)

(3) Topography: LEVEL  
(Hilly) (Flat) (Level)

(4) Purpose of Well: DOMESTIC  
(Domestic Irrigation  
Municipal, Industrial, Other)

Description & Color of Materials Sand, Clay, Red Clay, Shell, etc.	Thick- ness Feet	Depth Feet
CLAY	9	0
SAND & GRAVEL	11	9
BLUE CLAY	56	20
BLUE SAND	17	76
BLUE CLAY	8	93
BLUE SAND	34	101

Information upon completion of well:

(1) Diameter 4 inches.

(2) Total Depth 135 feet.

(3) Water Level 12 feet below top of ground.


(4) Cased to 24', Size 4"

(5) Screen: Size \_\_\_\_\_, Length \_\_\_\_\_

(6) Were any formations sealed against pollution?  
\_\_\_\_\_ yes, \_\_\_\_\_ no.

If YES depth of formation \_\_\_\_\_  
Why \_\_\_\_\_

Drillers Remarks: \_\_\_\_\_  
\_\_\_\_\_  
\_\_\_\_\_

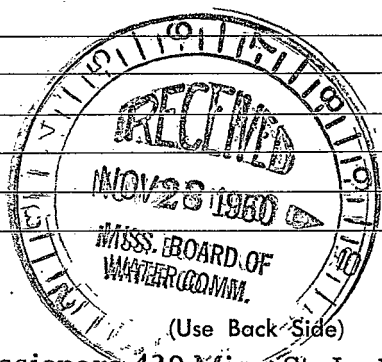

Well No.

1911

1912

1913

1914

1915

1916

1917