

6

11-6-61

WATER WELL DRILLERS LOG

Date: Nov. 6, 1961, Driller: W. B. Clardy County Lowndes

(Name)

(1) Owner of Land: Brown  
 (Name)  
Broadacres  
 (Address)

(2) Location: \_\_\_ 1/4, \_\_\_ 1/4, Sec. \_\_\_ T. R. \_\_\_  
Inside city limits of Clarks  
 (distance) (direction) (Nearest Town)

(3) Topography: flat  
 (Hilly) (Flat) (Level)

(4) Purpose of Well: Domestic  
 (Domestic Irrigation, Municipal, Industrial, Other)

Description & Color of Materials Sand, Clay, Red Clay, Shell, etc.	Thick-ness Feet	Depth Feet
---	-----------------	------------

Sand, gravel 16' - 20'		
Blue Clay - 20' - 100'		
Sand - 100' - 110'		
Clay - 110' - 185'		
Sand - 185' - 200'		

Information upon completion of well:

(1) Diameter 4 inches.

(2) Total Depth 205' feet.

(3) Water Level 70 feet below top of ground.

(4) Cased to 48, Size 4


(5) Screen: Size \_\_\_\_\_, Length \_\_\_\_\_

(6) Were any formations sealed against pollution?  
 \_\_\_\_\_ yes, \_\_\_\_\_ no.

If YES depth of formation \_\_\_\_\_

Why \_\_\_\_\_

Drillers Remarks: \_\_\_\_\_

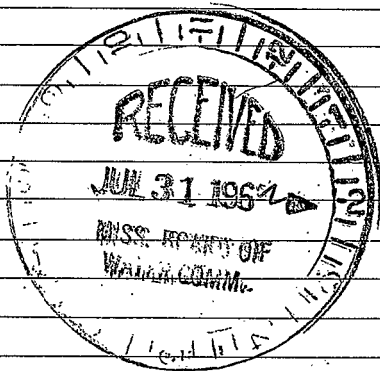

(Use Back Side)

Well No.

