

6
11-2-62

WATER WELL DRILLERS LOG

Date: Nov. 2, 1962, Driller: W. B. Hardy County _____
(Name)

1181

(1) Owner of Land: Delta Motor Line
(Name)
Airline Rd
(Address)

Description & Color of Materials
Sand, Clay, Red Clay, Shell, etc.

Thick-
ness
Feet

Depth
Feet

(2) Location: _____ 1/4, _____ 1/4, Sec. _____ T _____ R _____
1/2 miles E of Coals.
(distance) (direction) (Nearest Town)

Gravel + Sand 4' - 15'
Clay - 15' - 45'
Sand - 45' - 53'
Clay - 53' - 65'
Sand - 65' - 75'

(3) Topography: _____
(Hilly) (Flat) (Level)


(4) Purpose of Well: Industrial
(Domestic Irrigation
Municipal, Industrial, Other)

Information upon completion of well:

- (1) Diameter 4 inches.
- (2) Total Depth 75 feet.
- (3) Water Level 6 feet below top of ground.
- (4) Cased to 24, Size 4"
- (5) Screen: Size _____, Length _____
- (6) Were any formations sealed against pollution?
_____ yes, _____ no.

If YES depth of formation _____
Why _____

Drillers Remarks: _____

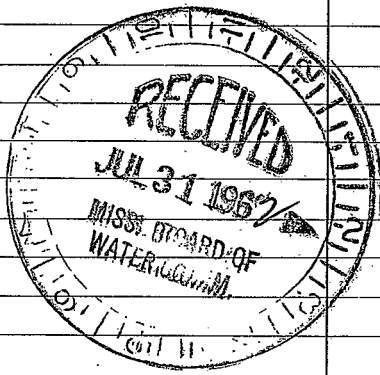

(Use Back Side)

Well No. _____

