

LOWNOES

MISSISSIPPI BOARD OF WATER COMMISSIONERS

G

3-30-63

WATER WELL DRILLERS LOG

Date: 3/30, 1963, Driller: W.B. Clardy County: Lowndes

(Name)

Conn. Contractor

(1) Owner of Land:

(Name)

Pine Haven Sub.

(Address)

(2) Location: 1/4, 1/4, Sec. T R

1 miles So. of Colo. (distance) (direction) (Nearest Town)

(3) Topography:

(Hilly) (Flat) (Level)

(4) Purpose of Well: Domestic

(Domestic Irrigation, Municipal, Industrial, Other)

Description & Color of Materials Sand, Clay, Red Clay, Shell, etc.

Thick-ness Feet

Depth Feet

Sand + Gravel 12' to 16'
Blue clay 16' to 50'
Sand at 50' to 55'
Blue clay 55' to 120'
Sand 120' to 135'

Information upon completion of well:


- (1) Diameter 4 inches.
(2) Total Depth 135 feet.
(3) Water Level 5 feet below top of ground.
(4) Cased to 21', Size 4"
(5) Screen: Size, Length
(6) Were any formations sealed against pollution?

yes, no.

If YES depth of formation

Why

Drillers Remarks:

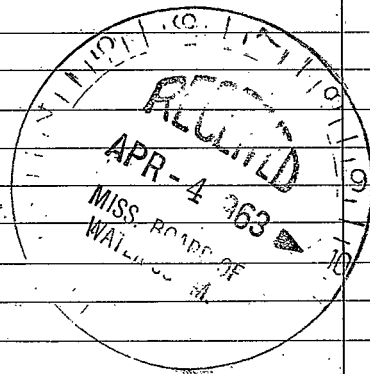

(Use Back Side)

Well No.

