

G

7-63

WATER WELL DRILLERS LOG

Date: July, 1963, Driller: W B Clardy County Lowndes
 (Name)

(1) Owner of Land:	Description & Color of Materials Sand, Clay, Red Clay, Shell, etc.	Thick- ness Feet	Depth Feet
<u>Choice Conn</u> (Name) <u>Columbus, Miss.</u> (Address)	<u>Sand + gravel 10-15</u> <u>Blue Clay 15-120</u> <u>Sand 120-135</u>		
(2) Location: <u>1/4</u> , <u>1/4</u> , Sec. <u> </u> T <u> </u> R <u> </u> <u>2</u> miles <u>S</u> of <u>Colo.</u> (distance) (direction) (Nearest Town)			
(3) Topography: <u>Level</u> (Hilly) (Flat) (Level)			
(4) Purpose of Well: (Domestic Irrigation Municipal, Industrial, Other)			


Information upon completion of well:

- (1) Diameter 4 inches.
- (2) Total Depth 135 feet.
- (3) Water Level 5 feet below top of ground.
- (4) Cased to 21, Size 4"
- (5) Screen: Size , Length .
- (6) Were any formations sealed against pollution?
 yes, no.

If YES depth of formation

Why

Drillers Remarks:

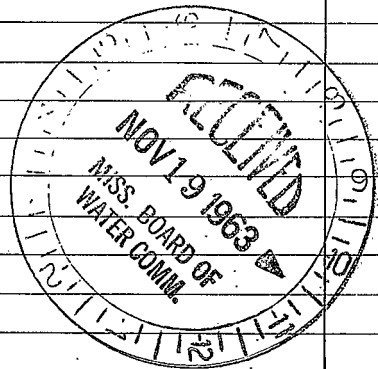

(Use Back Side)

Well No.

[The page contains extremely faint and illegible text, likely bleed-through from the reverse side of the document. No specific words or phrases can be discerned.]