

LOWNDES
G
6-17-77

MISSISSIPPI
 BOARD OF WATER COMMISSIONERS
 416 North State Street
 Jackson, Mississippi 39201

WATER WELL DRILLERS LOG

6-17 1976 W J REEVES & SON LOWNDES
 date well completed firm name county well located

LANDOWNER: PHILLIPS CONTRS.
WATER WORKS RD.
COLUMBUS
 (mailing address)

description of formations encountered	from	to
CLAY	0	16
SAND & GRAVEL	16	37
BLUE CLAY	37	88
" SAND	88	105
" CLAY	105	138
" SAND	138	160
" CLAY	160	172
" SAND	172	200

WELL LOCATION:
 sec. 7 T. N R. E
 S W
0 miles of COLUMBUS
 (distance) (direction) (nearest town)

Need water

WELL PURPOSE: IND.
 (home, irrigation, municipal, industrial)

WELL COMPLETION DATA:

(1) diameter (inches) 4

(2) total depth (feet) 200

(3) static water level (feet) 25 below above top of ground.

(4) casing STEEL, 4 1/2
 (material) (depth)
4 If telescope see back.
 (size)

(5) screen _____
 (length) (depth to top)
 (size) (material)

(6) pump 3/4 15
 (HP) (yield gpm)
ELECT
 (type power)

(7) electric log NO
 (yes or no)
 (organization running log)

(8) how well bottom plugged OPEN


RECEIVED
 APR 12 1977

DRILLERS REMARKS:

MISS. Bd. OF WATER COMM.

If well telescopes please sketch and show depths.

GROUND LEVEL

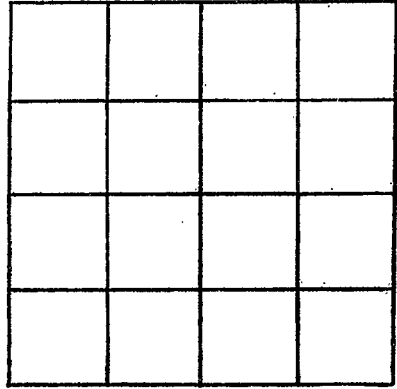

SECTION _____

Please indicate well location X.

ADDITIONAL INFORMATION

If more than one screen, show locations of each on sketch.