

LOWNDES
G 7
3-1-71

MISSISSIPPI
BOARD OF WATER COMMISSIONERS
416 North State Street
Jackson, Mississippi 39201

CODED

WATER WELL DRILLERS LOG

3-1 1971 W.J. REEVES & SON LOWNDES
date well completed firm name county well located

LANDOWNER: JAMES HILL
510 Lehigh Berg Rd.

864 BALL RD.
MEMPHIS, TENN.
(mailing address)

WELL LOCATION:
sec. 12 T-18 S R-18 W
1 miles E of COLOMBUS
(distance) (direction) (nearest town)

WELL PURPOSE: I.R.D.
(home, irrigation, municipal, industrial)

WELL COMPLETION DATA:

- (1) diameter (inches) 4
- (2) total depth (feet) 140
- (3) static water level (feet) 12 below above top of ground.
- (4) casing STEEL 162 (material) (depth)
4 (size) if telescope see back.
- (5) screen NONE (length) (depth to top)
(size) (material)
- (6) pump 2 20 (HP) (yield gpm)
ELECT (type power)
- (7) electric log NO (yes or no)
(organization running log)

(8) how well bottom plugged OPEN

description of formations encountered	from	to
CLAY	0	18
SAND GRAVEL	18	31
BLUE SAND	31	58
CLAY	58	90
SAND	90	104
CLAY	104	122
SAND	122	135
CLAY	135	140


CODED

MAR 16 1971

DRILLERS REMARKS:

If well telescopes please sketch and show depths.

GROUND LEVEL

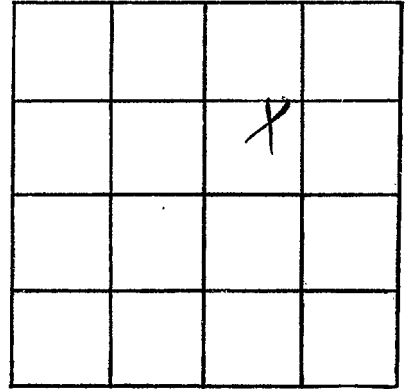

SECTION 12

Please indicate well location X.

ADDITIONAL INFORMATION

If more than one screen, show locations of each on sketch.