

Lawendes
637
 7-31-68

MISSISSIPPI
 BOARD OF WATER COMMISSIONERS
 416 North State Street
 Jackson, Mississippi 39201

WATER WELL DRILLERS LOG

7-31
 date well completed

1968 *Martin S. Ridgeway*
 firm name

Lawendes
 county well located

LANDOWNER: *W.B. [unclear]*

Columbus, Miss

description of formations encountered

from to

#W 82 E. 328 7781
 (mailing address)

<i>Clay</i>	<i>0</i>	<i>12</i>
<i>Gravel</i>	<i>12</i>	<i>28</i>
<i>Bl. shale</i>	<i>28</i>	<i>110</i>
<i>Sand & shale streaks</i>	<i>110</i>	<i>135</i>


WELL LOCATION:
 sec. *24* T. *18* N R. *18* W
1/4 miles *E 32 mi* of *Columbus*
 (distance) (direction) (nearest town)

WELL PURPOSE:
 (home, irrigation, municipal, industrial)

WELL COMPLETION DATA:

- (1) diameter (inches) _____
- (2) total depth (feet) 135'
- (3) static water level (feet) 6 below/above top of ground.
- (4) casing 4" (material), 42' (depth),
 _____ if telescope see back.
 (size)
- (5) screen _____ (length), _____ (depth to top)
 _____ (size), _____ (material)
- (6) pump _____ (HP), _____ (yield gpm)
 _____ (type power)
- (7) electric log _____ (yes or no)
 _____ (organization running log)
- (8) how well bottom plugged _____


CODED

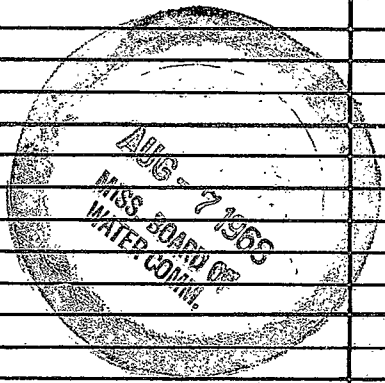

DRILLERS REMARKS:

If well telescopes please sketch and show depths.

GROUND LEVEL

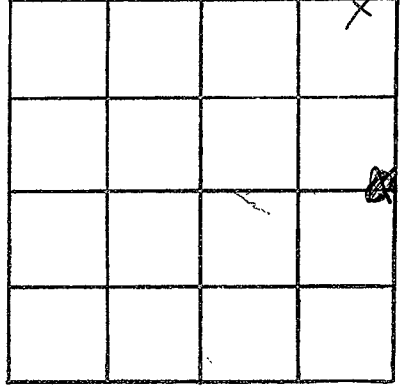

SECTION _____

Please indicate well location X.

ADDITIONAL INFORMATION

well is located 1/2 mi
east of city limit on
east 182 highway on south
side of highway at
Trailer Sales Business
owned by Mr W.B. Mott.

If more than one screen, show locations of each on sketch.