

Lowndes
G-39
11-26-68

MISSISSIPPI
 BOARD OF WATER COMMISSIONERS
 416 North State Street
 Jackson, Mississippi 39201

CODED

WATER WELL DRILLERS LOG

11-26 1968 W.J. REEVES & SON LOWNDES
 date well completed firm name county well located

LANDOWNER: FLOYD FIELDS
 #W 50 HOUSTON FIELDS
TUSCALOOSA RD.

description of formations encountered	from	to
SANDY CLAY	0	6
SAND & GRAVEL	6	26
BLUE SAND	26	30
" CLAY	30	64
" SAND	64	73
" CLAY	73	82
" SAND	82	106
" CLAY	106	110

COLUMBUS, MISS-
 (mailing address)

WELL LOCATION:
 sec. 11 T 18 # R 18 E
 S W
1 miles N of COLUMBUS
 (distance) (direction) (nearest town)

WELL PURPOSE: HOME
 (home, irrigation, municipal, industrial)

- WELL COMPLETION DATA:
- (1) diameter (inches) 4
 - (2) total depth (feet) 110'
 - (3) static water level (feet) 12 below top of ground.
 - (4) casing STEEL, 33'
 (material) (depth)
4 if telescope see back.
 (size)
 - (5) screen NONE
 (length) (depth to top)
 (size) (material)
 - (6) pump 1/3 6
 (HP) (yield gpm)
ELECT
 (type power)
 - (7) electric log NO
 (yes or no)
 (organization running log)

(8) how well bottom plugged OPEN

DRILLERS REMARKS:


CODED

JAN 10 1968

MISS. DEP. OF
 WATER CONTROL
 JEFFERSON COUNTY

If well telescopes please sketch and show depths.

GROUND LEVEL

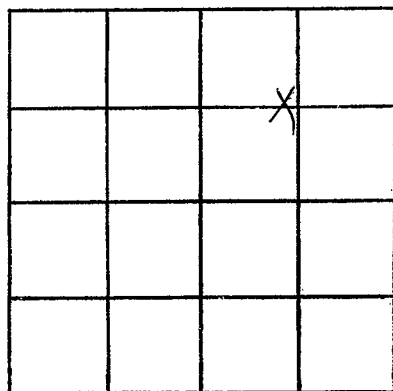

SECTION 11

Please indicate well location X.

ADDITIONAL INFORMATION

If more than one screen,
show locations of each on sketch.