

LOWMEDES

CODED

G40

9-14-68

MISSISSIPPI BOARD OF WATER COMMISSIONERS 416 North State Street Jackson, Mississippi 39201

WATER WELL DRILLERS LOG

9-14

1968 W. J. REEVES & SON

LOWMEDES

date well completed

firm name

county well located

LANDOWNER: RADIOLOGY CLINIC

description of formations encountered

from

to

COLUMBUS, Miss.

2526 5th N. 328840Z (mailing address)

Table with 3 columns: description of formations encountered, from, to. Rows include CLAY, SAND & GRAVEL, BLUE SAND, CLAY, SAND, CLAY, SAND, CLAY, SAND, CLAY, SAND.

WELL LOCATION:

4 sec 18 T 18 N R 18 E of COLUMBUS (distance) (direction) (nearest town)

WELL PURPOSE: CLINIC (home, irrigation, municipal, industrial)

WELL COMPLETION DATA:

- (1) diameter (inches) 4
(2) total depth (feet) 196
(3) static water level (feet) 10 below top of ground.
(4) casing STEEL, 50' (material) (depth)
(5) screen NONE (length) (depth to top)
(6) pump 1/2 HP, 10 (yield gpm)
(7) electric log NO (yes or no)
(8) how well bottom plugged OPEN


CODED

DRILLERS REMARKS:

MISS. Bd. OF WATER COMMISSIONERS

If well telescopes please sketch and show depths.

GROUND LEVEL

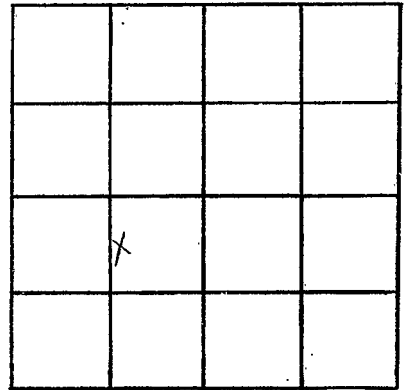

SECTION 4

Please indicate well location X.

ADDITIONAL INFORMATION

If more than one screen, show locations of each on sketch.