

Lowndes
G41
10-31-68

MISSISSIPPI
 BOARD OF WATER COMMISSIONERS
 416 North State Street
 Jackson, Mississippi 39201

CODED

WATER WELL DRILLERS LOG

10-31 1968 W. J. REEVES & SON LOWNDES
 date well completed firm name county well located

LANDOWNER: CHOICE CONN
RT. 1
 3286000

description of formations encountered	from	to
CLAY	0	11
SAND & GRAVEL	11	28
BLUE CLAY	28	64
" SAND	64	72
" CLAY	72	81
" SAND	81	92
" CLAY	92	98
" SAND	98	112

STEEN'S, MISS-
 (mailing address)

WELL LOCATION:
 sec. 11 T 18 S R. 18 E W
1/2 miles E of COLUMBUS
 (distance) (direction) (nearest town)

WELL PURPOSE: HOME
 (home, irrigation, municipal, industrial)

WELL COMPLETION DATA:

- (1) diameter (inches) 4
- (2) total depth (feet) 112
- (3) static water level (feet) 8 below top of ground. above
- (4) casing STEEL, 3 1/2 (material) (depth)
4 (size) if telescope see back.
- (5) screen NONE (length) (depth to top)
 (size) (material)
- (6) pump NONE (HP) (yield gpm)
 (type power)
- (7) electric log NO (yes or no)
 (organization running log)
- (8) how well bottom plugged OPEN

CODED


JAN 7 1968

MISS. Bd. of
 WATER COMMISSIONERS

DRILLERS REMARKS:

If well telescopes please sketch and show depths.

GROUND LEVEL

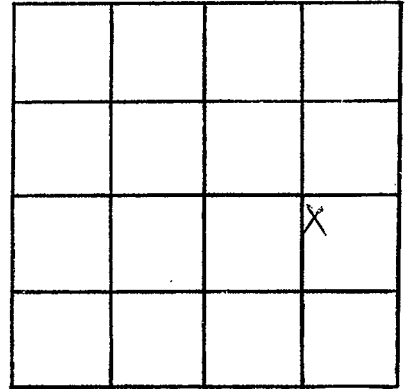

SECTION 11

Please indicate well location X.

ADDITIONAL INFORMATION

If more than one screen,
show locations of each on sketch.