

CODED

CODED

Lounides
G42
11-23-68

MISSISSIPPI
BOARD OF WATER COMMISSIONERS
416 North State Street
Jackson, Mississippi 39201

WATER WELL DRILLERS LOG

11-23 1968 W.J. REEVES & SON LOUNIDES
date well completed firm name county well located

LANDOWNER: CHURCH OF CHRIST

description of formations encountered	from	to
CLAY	0	16
SAND & GRAVEL	16	21
BLUE CLAY - THIN SAND STRKS.	21	130

HWAY 69
COLUMBUS, MISS.
(mailing address)

WELL LOCATION:
sec. 35 T. 18 N. R. 18 E. S. 2
(distance) miles (direction) of Columbus (nearest town)

WELL PURPOSE: CHURCH
(home, irrigation, municipal, industrial)

WELL COMPLETION DATA:

- (1) diameter (inches) 4
- (2) total depth (feet) 130
- (3) static water level (feet) 8 below top of ground
- (4) casing STEEL 24' (material) (depth)
4 (size) If telescope see back.
- (5) screen NONE (length) (depth to top)
- (6) pump 1/3 (HP) 6 (yield gpm)
ELECT (type power)
- (7) electric log NO (yes or no)

CODED
CODED

CODED

(organization running log)

(8) how well bottom plugged OPEN


DRILLERS REMARKS

JAN 7 1969

REC. BY
DATE

If well telescopes please sketch and show depths.

GROUND LEVEL

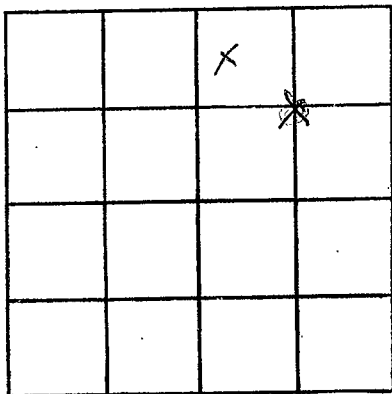

SECTION 35

Please indicate well location X.

ADDITIONAL INFORMATION

If more than one screen,
show locations of each on sketch.