

CODED

CODED

Lowndes  
G45  
1-69

MISSISSIPPI  
BOARD OF WATER COMMISSIONERS  
416 North State Street  
Jackson, Mississippi 39201

WATER WELL DRILLERS LOG

Law - 69, Clardy Well Drilling, Lowndes  
date well completed firm name county well located

LANDOWNER: W.K. Dims  
Sylvan Rd.  
Colo. Miss.  
(mailing address)

description of formations encountered from to

WELL LOCATION:  
sec. 11 T. 18 N R. 18 E  
1 miles of Colo.  
(distance) (direction) (nearest town)

0 - 10 Top soil  
10 - 30 Sand & gravel  
30 - 41 Blue Clay  
41 - 42 Sandy Struck  
42 - 55 Blue Clay  
55 - 80 Sandy Struck  
80 - 135 Blue Clay  
135 - 140 Sand

WELL PURPOSE:  
(home, irrigation, municipal, industrial)

WELL COMPLETION DATA:

(1) diameter (inches) 4"  
(2) total depth (feet) 140  
(3) static water level (feet) 8' below top of ground.  
(4) casing Steel 3 7/8"  
(material) (depth)

(size) if telescope see back.

(5) screen (length) (depth to top)  
(size) (material)

(6) pump 1/2 hp Subv. 700 gph  
(HP) (yield gpm)  
(type power)

(7) electric log No  
(yes or no)

(organization running log)

(8) how well bottom plugged

DRILLERS REMARKS:

CODED


CODED

MAR 11 1969

MISS. BD. OF  
WATER COMMISSIONERS

If well telescopes please sketch and show depths.

GROUND LEVEL

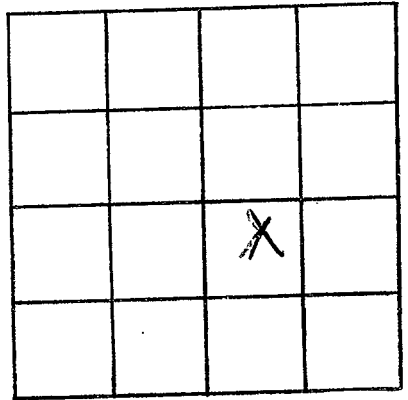

SECTION 11

Please indicate well location X.

ADDITIONAL INFORMATION

If more than one screen, show locations of each on sketch.