

CODED

MISSISSIPPI
BOARD OF WATER COMMISSIONERS
416 North State Street
Jackson, Mississippi 39201

WATER WELL DRILLERS LOG

LOWNDES

647

6-6-69

6-6 1969 W.J. REEVES & SON LOWNDES
date well completed firm name county well located

^{DIFFERENT} LANDOWNER: LEON MORGAN

BUILT HOUSE

description of formations encountered

from to

RT. 1, STEENS

CLAY	0	9
SAND & GRAVEL	9	18
BLUE CLAY	18	51
" SAND	51	56
" CLAY	56	101
" SAND	101	113
" CLAY	113	135
" SAND	135	141
" CLAY	141	147
" SAND	147	160

(mailing address)

WELL LOCATION:

NE Sec 26 T. 18 R. 18 S
SW 1 miles SO of COLUMBUS
(distance) (direction) (nearest town)

WELL PURPOSE: HOME
(home, irrigation, municipal, industrial)

WELL COMPLETION DATA:

- (1) diameter (inches) 4
- (2) total depth (feet) 160
- (3) static water level (feet) 10 below top of ground.
- (4) casing STEEL, 22 1/2,
(material) (depth)
- 4 if telescope see back.
(size)
- (5) screen NONE
(length) (depth to top)
- (size) (material)
- (6) pump 1/2 10
(HP) (yield gpm)
- ELECT
(type power)
- (7) electric log NO
(yes or no)
- (organization running log)
- (8) how well bottom plugged OPEN

CODED


AUG 18 1969

MISS. BD. OF WATER COMMISSIONERS

DRILLERS REMARKS:

If well telescopes please sketch and show depths.

GROUND LEVEL

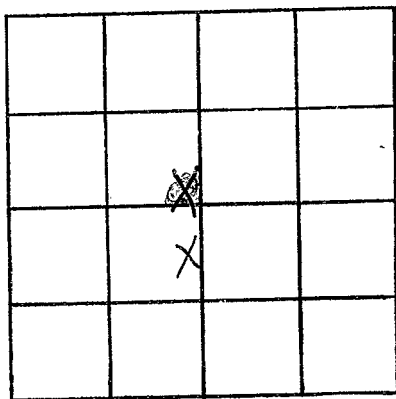

SECTION 26

Please indicate well location X.

ADDITIONAL INFORMATION

If more than one screen,
show locations of each on sketch.