

CODED

LOWNDES
648
6-16-69

MISSISSIPPI
BOARD OF WATER COMMISSIONERS
416 North State Street
Jackson, Mississippi 39201

WATER WELL DRILLERS LOG

6-16 1969 W.J. REEVES & SON LOWNDES
date well completed firm name county well located

ACROSS FROM BOSTIE

LANDOWNER: ROBT. W. MALONE

description of formations encountered	from to	
	feet	feet
CLAY	0	18
SAND & GRAVEL	18	26
BLUE CLAY	26	57
" SAND	57	98
" CLAY	98	105
" SAND	105	111
" CLAY	111	119
" SAND	119	135

Rt. 4 Nashville Ferry Rd
3280664

COLUMBUS
(mailing address)

WELL LOCATION:
sec 34 T 18 S R 18 E
1 miles S of COLUMBUS
(distance) (direction) (nearest town)

WELL PURPOSE: HOME
(home, irrigation, municipal, industrial)

WELL COMPLETION DATA:

- (1) diameter (inches) 4
- (2) total depth (feet) 135
- (3) static water level (feet) 22 below top of ground
- (4) casing STEEL 30 (material), (depth)
4 (size) if telescope see back.
- (5) screen NONE (length), (depth to top)
(size), (material)
- (6) pump 3/4 9 (HP), (yield gpm)
ELECT (type power)
- (7) electric log NO (yes or no)
(organization running log)
- (8) how well bottom plugged OPEN

CODED


AUG 18 1969

DRILLERS REMARKS:

MISS. BD. OF
WATER COM.

If well telescopes please sketch and show depths.

GROUND LEVEL

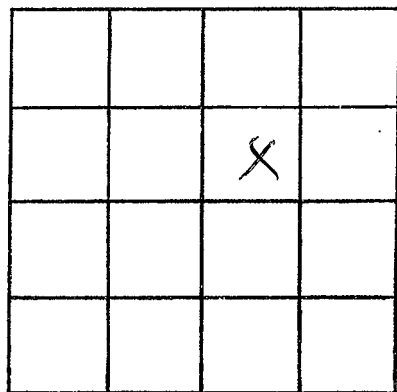

SECTION 34

Please indicate well location X.

ADDITIONAL INFORMATION

If more than one screen,
show locations of each on sketch.