

CODED

MISSISSIPPI
BOARD OF WATER COMMISSIONER
416 North State Street
Jackson, Mississippi 39201

CODED

WATER WELL DRILLERS LOG

LOWNDES
G 49
7-17-69

7-17
date well completed

1969 W. J. REEVES & SON
firm name

LOWNDES
county well located

LANDOWNER: MORRIS SMITH

description of formations encountered

from to

1205 No. 7TH ST.

COLUMBUS

(mailing address)

WELL LOCATION:

sec. 9 T. 18 N. R. 18 E. S. 5
0 miles of COLUMBUS
(distance) (direction) (nearest town)

WELL PURPOSE: YARD
(home, irrigation, municipal, industrial)

WELL COMPLETION DATA:

- (1) diameter (inches) 4
- (2) total depth (feet) 290
- (3) static water level (feet) 18 below top of ground.
- (4) casing STEEL, 138 (material), (depth)
- (size) if telescope see back.
- (5) screen NONE (length), (depth to top)
- (size), (material)
- (6) pump 1 1/2 (HP), 23 (yield gpm)
- ELECT (type power)
- (7) electric log NO (yes or no)
- (organization running log)
- (8) how well bottom plugged OPEN

CLAY	0	19
GRAY SAND	19	35
BLUE CLAY	35	64
" SAND	64	67
" CLAY	67	117
" SAND	117	136
" CLAY	136	148
" SAND	148	162
" CLAY	162	167
" SAND	167	175
" CLAY	175	268
GRAY SAND	268	290

CODED


SEP - 2 1969

DRILLERS REMARKS:

MISSISSIPPI BOARD OF WATER COMMISSIONERS

If well telescopes please sketch and show depths.

GROUND LEVEL

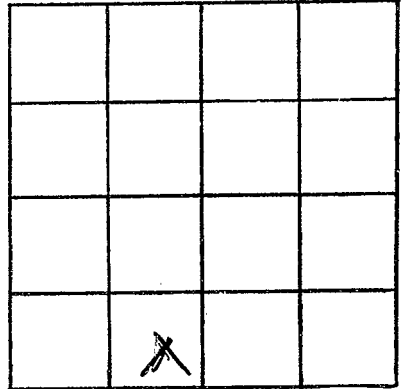

SECTION 9

Please indicate well location X.

ADDITIONAL INFORMATION

If more than one screen, show locations of each on sketch.