

CODED

MISSISSIPPI  
BOARD OF WATER COMMISSIONERS  
416 North State Street  
Jackson, Mississippi 39201

WATER WELL DRILLERS LOG

COLUMBUS WELLS DRILLING & DIGGING SER.  
420 IDELWILD

LOWNDES  
G 50  
3-8-69

3-8-69  
date well completed

19 COLUMBUS MISSISSIPPI 39701  
firm name  
DIDN'T HAVE A WELL DRILLED

Lowndes  
county well located

LANDOWNER: Maggie Wright  
328 2849  
433 16<sup>th</sup> St. South  
Columbus Miss.  
(mailing address)

description of formations encountered	from	to
Blue Clay	0	24
Hard blue clay	24	36
Soft blue clay	36	66
Hard blue clay	66	96
Fine sand	96	110
Rock	110	111
Coarse Sandy streaks	111	118
Blue clay	118	120

WELL LOCATION:  
sec 29 T 18 N R 18 E  
S W  
Columbus  
(distance) miles (direction) of (nearest town)

WELL PURPOSE: Home  
(home, irrigation, municipal, industrial)

- WELL COMPLETION DATA:
- (1) diameter (inches) 4"
  - (2) total depth (feet) 120'
  - (3) static water level (feet) 45' below top of ground.
  - (4) casing 26' (Steel) (material), (depth)  
(size) if telescope see back.
  - (5) screen None (length), (depth to top)  
None installed (size) (material)
  - (6) pump None installed (HP) (yield gpm)  
(type power)
  - (7) electric log No (yes or no)  
(organization running log)
  - (8) how well bottom plugged


DRILLERS REMARKS:

SEP - 3 1969

MISS. DEP. OF  
WATER RESOURCES

If well telescopes please sketch and show depths.

GROUND LEVEL

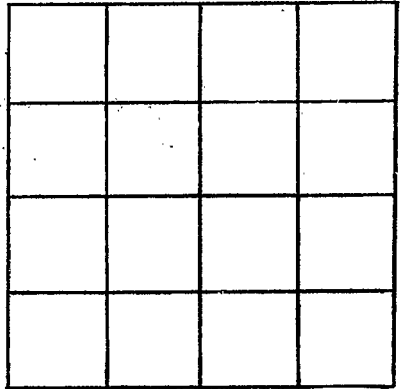

SECTION \_\_\_\_\_

Please indicate well location X.

ADDITIONAL INFORMATION

If more than one screen,  
show locations of each on sketch.