

MISSISSIPPI  
BOARD OF WATER COMMISSIONERS  
416 North State Street  
Jackson, Mississippi 39201

**CODED**

**WATER WELL DRILLERS LOG**

May 2, 19 69 Columbus Well Drilling Lowndes  
date well completed firm name county well located

LANDOWNER: Willie Stokes  
Yorkville Rd. 3286857  
Columbus Miss.  
(mailing address)

description of formations encountered	from	to
Clay	0	10
Sand & gravel	10	20
Blue rock	20	100
Streaks of sand & clay	100	105
Blue clay	105	140
Sandy blue clay	140	145
Sand	145	160

WELL LOCATION:  
26 ~~34~~ T. 18 N. R. 18 E. S. 4  
NE SW 4 miles South Columbus  
(distance) (direction) (nearest town)

WELL PURPOSE: home  
(home, irrigation, municipal, industrial)

**WELL COMPLETION DATA:**

- diameter (inches) 4"
- total depth (feet) 160'
- static water level (feet) 55' below top of ground.
- casing Steel 34' (material) (depth)  
(size) if telescope see back.
- screen None (length) (depth to top)  
(size) (material)
- pump 1/2 (HP) 350 (yield gpm) hr  
Elec (type power)
- electric log No (yes or no)  
(organization running log)
- how well bottom plugged Open


**CODED**

SEP - 3 1969

DRILLERS REMARKS:

If well telescopes please sketch and show depths.

GROUND LEVEL

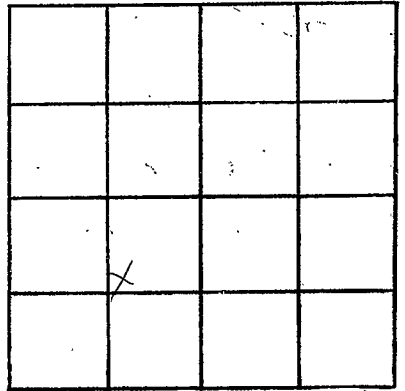

SECTION 26

Please indicate well location X.

ADDITIONAL INFORMATION

If more than one screen,  
show locations of each on sketch.