

**MISSISSIPPI
BOARD OF WATER COMMISSIONERS**
416 North State Street
Jackson, Mississippi 39201

CODED

LOWNDES
G 52
S-269

WATER WELL DRILLERS LOG

May 2, 19 69 Columbus Well Drilling Lowndes
date well completed firm name county well located

LANDOWNER: Arthur Beardley
Pinehaven Sub Div.
Columbus, Miss 3280047
(mailing address)

WELL LOCATION:
NW 23 T 18 N R 18 E
SW S
3 miles South of Columbus
(distance) (direction) (nearest town)

WELL PURPOSE: home
(home, irrigation, municipal, industrial)

- WELL COMPLETION DATA:
- (1) diameter (inches) 4"
 - (2) total depth (feet) 140'
 - (3) static water level (feet) 50 below above top of ground.
 - (4) casing Steel, 27'
(material) (depth)
 if telescope see back.
(size)
 - (5) screen NONE,
(length) (depth to top)
 (size) (material)
 - (6) pump 1/2 sub, 8
(HP) (yield/gpm)
 (type power)
 - (7) electric log NO
(yes or no)
 (organization running log)
 - (8) how well bottom plugged Open

description of formations encountered	from	to
Sandy clay	0	10
Sand & gravel	10	20
Blue clay	20	75
Sandy blue clay	75	85
Blue clay	85	95
Sandy blue clay	95	103
Fine sand	103	107
Blue clay	107	110
Streaks of sand & clay	110	115
Blue Clay	115	120
Streaks of sand & rock	120	130
Blue clay	130	140

CODED


SEP - 3 1969

MISS. DEPT. OF
WATER RESOURCES

DRILLERS REMARKS:

If well telescopes please sketch and show depths.

GROUND LEVEL

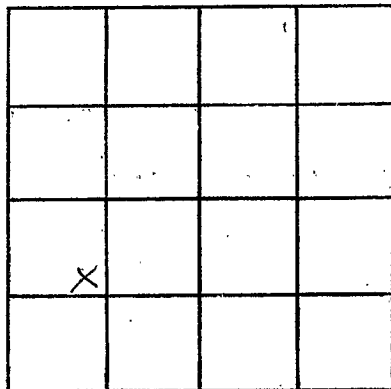

SECTION _____

Please indicate well location X.

ADDITIONAL INFORMATION

If more than one screen, show locations of each on sketch.