

CODED

MISSISSIPPI BOARD OF WATER COMMISSIONERS  
416 North State Street  
Jackson, Mississippi 39201

WATER WELL DRILLERS LOG

LOWNDES  
G54  
7-5-69

7-5-69 19 Columbus Well Drilling Lowndes  
date well completed firm name county well located  
- END OF MILL ST.

LANDOWNER: M. L. McCarty AG  
1323 3rd Ave. North  
Columbus, Miss. 39701  
(mailing address)

WELL LOCATION:  
City of Columbus 18  
sec. 17 T-18 S R-18 E  
(distance) miles of (direction) of (nearest town)

WELL PURPOSE: HOME CHAMP  
(home, irrigation, municipal, industrial)

WELL COMPLETION DATA:

- (1) diameter (inches) 4"
- (2) total depth (feet) 180'
- (3) static water level (feet) 3' below above top of ground.
- (4) casing Steel 62 feet (material) (depth)  
If telescope see back. (size)
- (5) screen No (length) (depth to top)  
(size) (material)
- (6) pump 1/2 Sub. 600 Mc (HP) (yield gpm)  
(type power)
- (7) electric log No (yes or no)  
(organization running log)
- (8) how well bottom plugged Open

description of formations encountered	from	to
Fair blue clay	57	65
Soft streak	65	66
Good blue clay	66	90
Sandy streak	90	91
Blue clay	91	100
Rock	100	101
Sandy Streak	101	102
Blue Clay	102	115
Sandy Streak	115	116
Blue Clay	116	120
Sandy Streak	120	121
Robk	121	122
Sandy Clay	122	130
Rock	130	131
Sandy Clay	131	135
Rock	135	136
Sandy Streak & blue clay	136	175
Solid blue clay	175	180

CODED


SEP - 3 1969

DRILLERS REMARKS:

MISS. DEP. OF WATER CONTROL

If well telescopes please sketch and show depths.

GROUND LEVEL

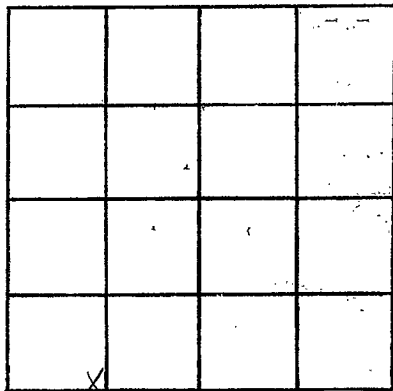

SECTION 11

Please indicate well location X.

ADDITIONAL INFORMATION

A series of horizontal lines for entering additional information, located to the right of the 'ADDITIONAL INFORMATION' header.

If more than one screen, show locations of each on sketch.