

Lowndes.

G 55

1-22-70

MISSISSIPPI
 BOARD OF WATER COMMISSIONERS
 416 North State Street
 Jackson, Mississippi 39201

COPIED

WATER WELL DRILLERS LOG

1-22-70 date well completed
 W.J. REEVES & SON firm name
 LOWNDES county well located

LANDOWNER: FLOYD FIELDS

BURNS
 402 TUSCUMBIA RD.
 CURTIS
 COLUMBUS
 (mailing address)

description of formations encountered	from to	
	feet	feet
SANDY SOIL	0	8
SAND & GRAVEL	8	26
BLUE CLAY + SAND STRS	26	31
BLUE CLAY	31	57
" SAND	57	71
" CLAY	71	80
" SAND	80	87
" CLAY	87	99
" SAND	99	110

WELL LOCATION:

sec. 12 T 18 S R 18 E W
 1 miles E of COLUMBUS
 (distance) (direction) (nearest town)

WELL PURPOSE: HOME
 (home, irrigation, municipal, industrial)

WELL COMPLETION DATA:

- (1) diameter (inches) 4
- (2) total depth (feet) 110
- (3) static water level (feet) 6 below top of ground.
- (4) casing STEEL 34' (material) (depth)
 4" (size) if telescope see back.
- (5) screen NONE (length) (depth to top)
 (size) (material)
- (6) pump 1/3 7 (HP) (yield gpm)
 ELECT. (type power)
- (7) electric log NO (yes or no)

(organization running log)

(8) how well bottom plugged OPEN


DRILLERS REMARKS:

FEB 26 1970

MISS. DEPT. OF WATER CONW.

If well telescopes please sketch and show depths.

GROUND LEVEL

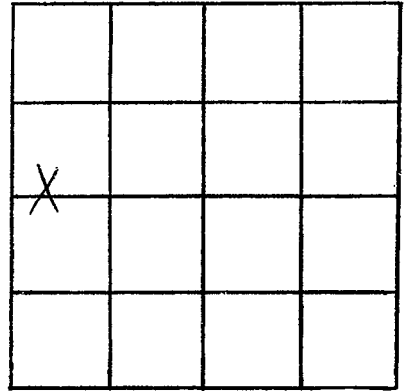

SECTION 12

Please indicate well location X.

ADDITIONAL INFORMATION

If more than one screen,
show locations of each on sketch.